



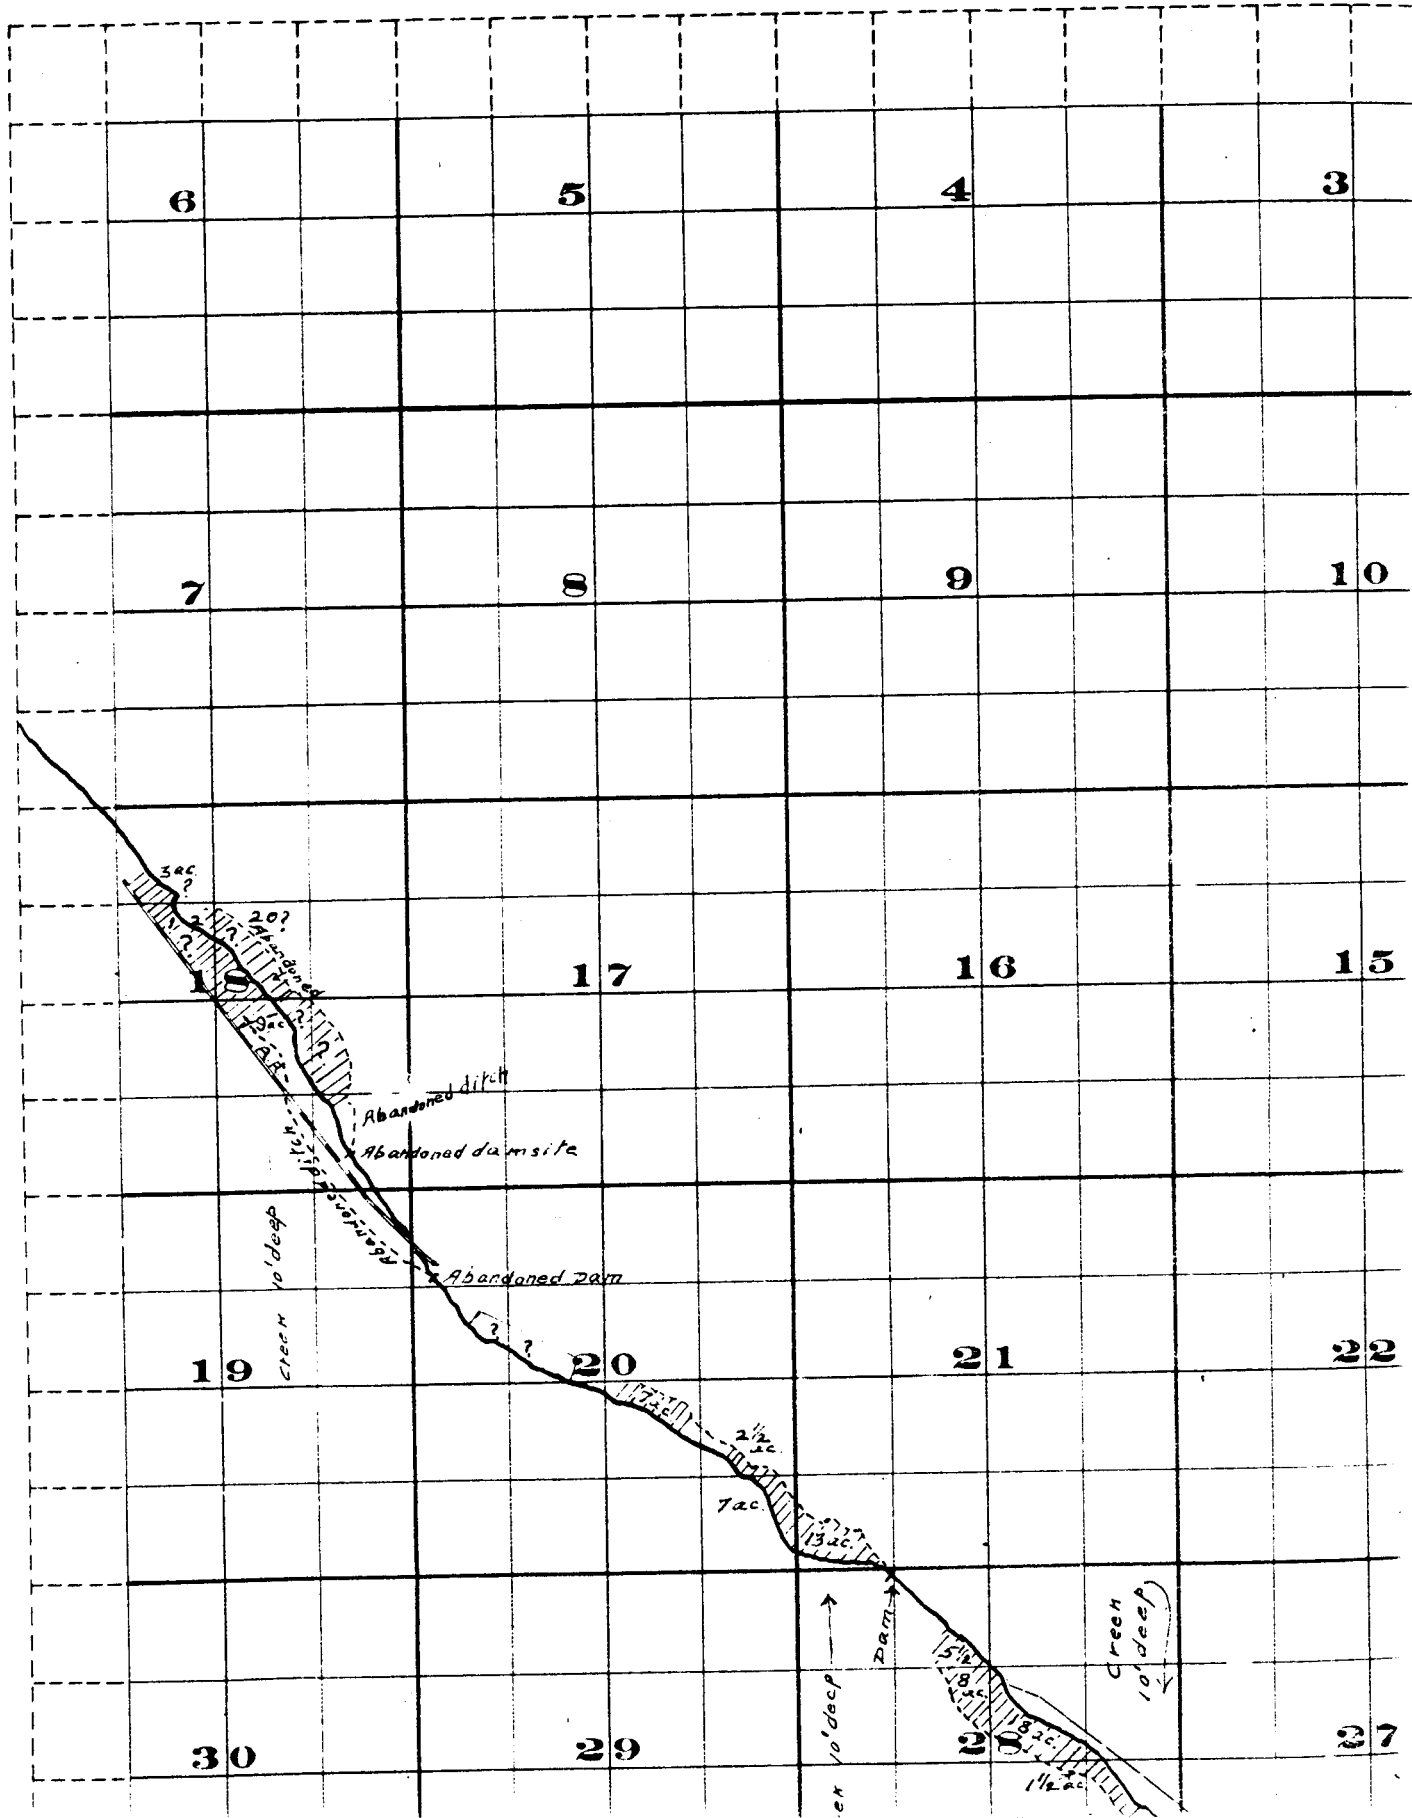

Township 1 S. , R.

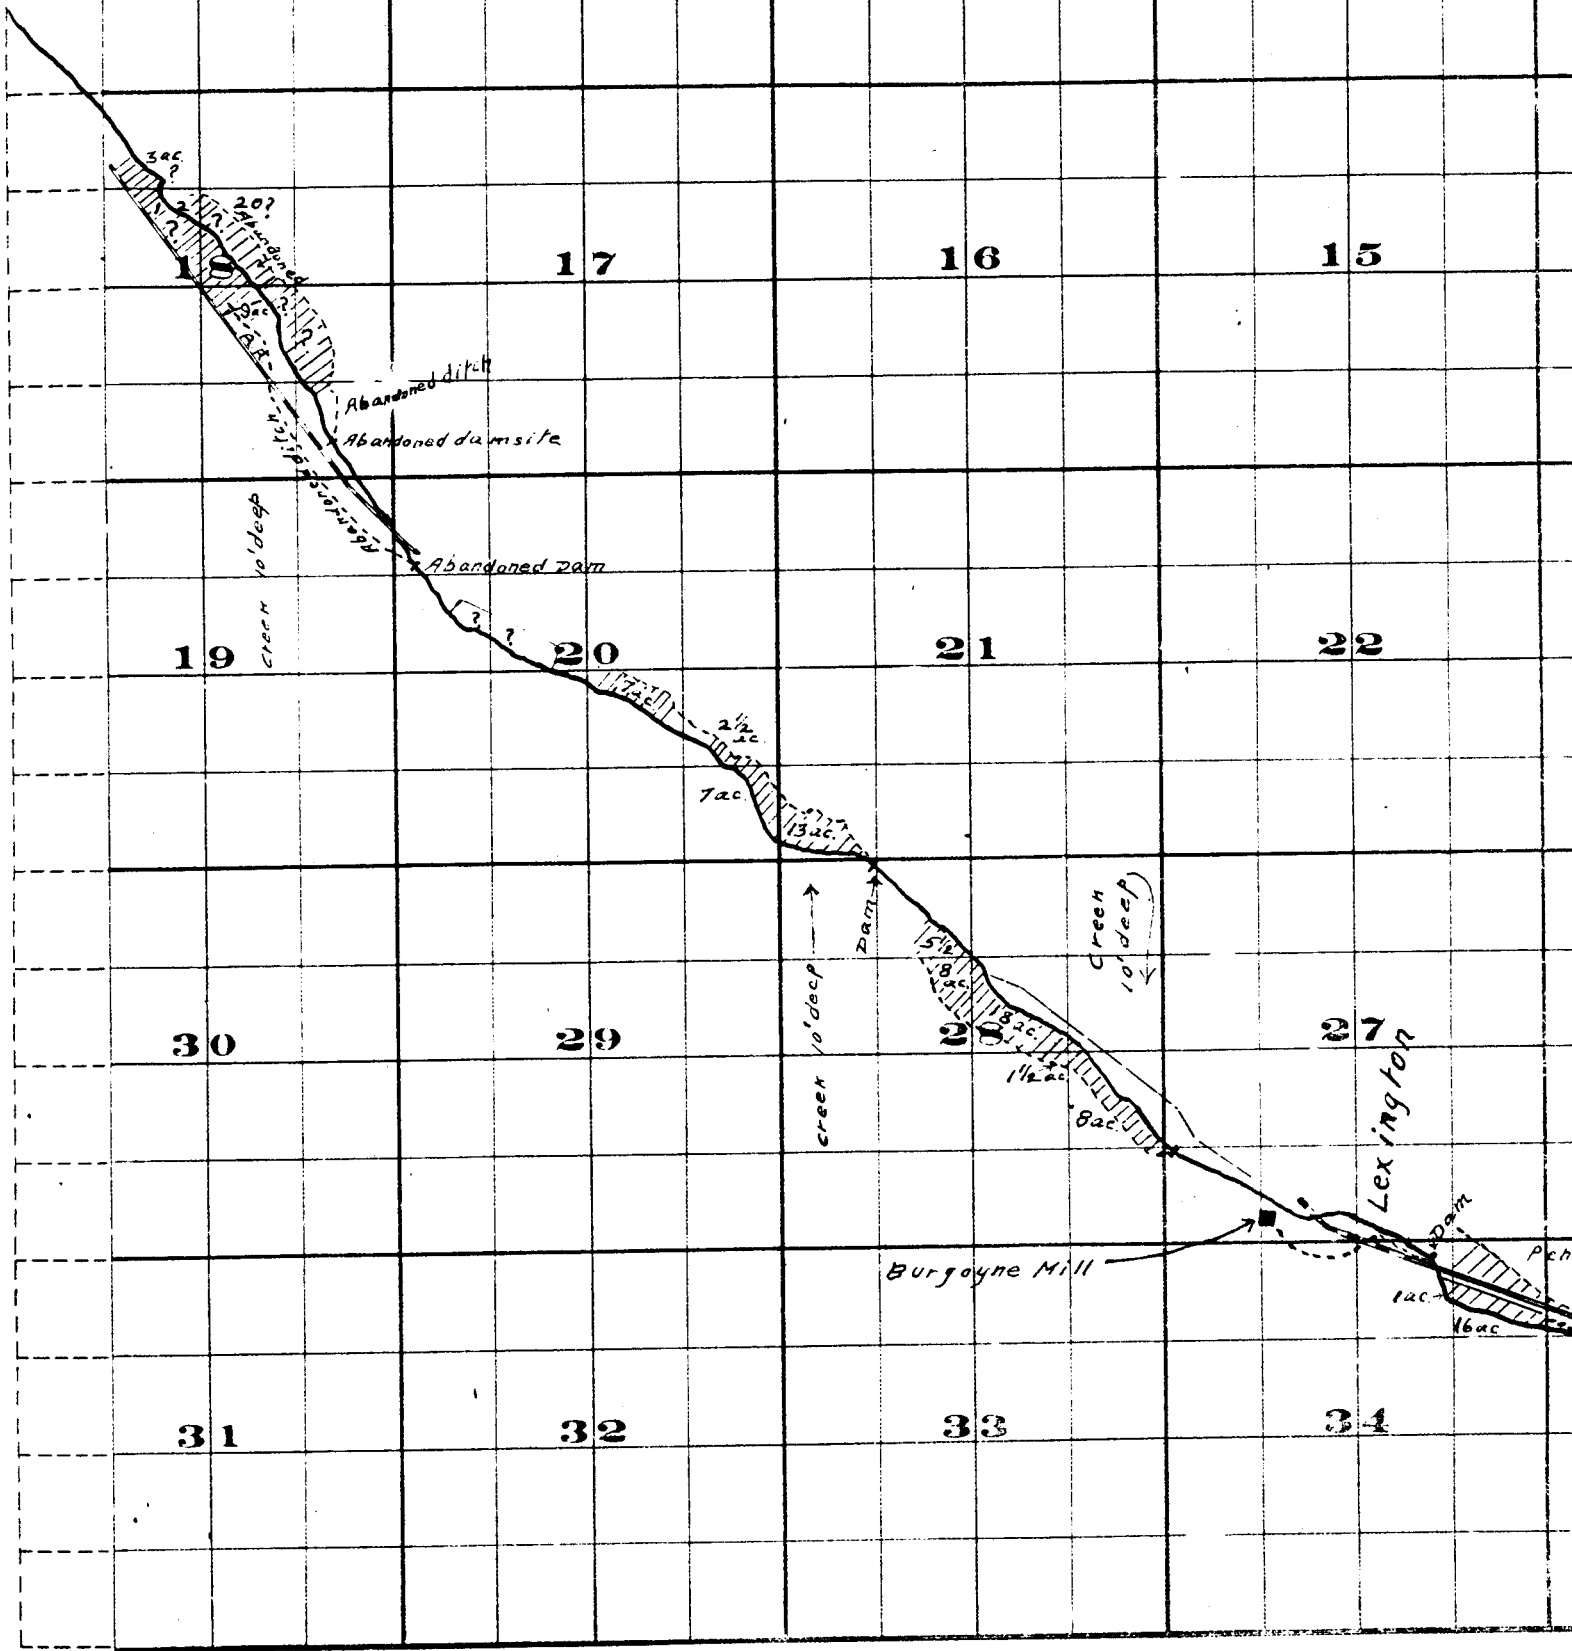




THE S. HASTON CO. PRINTERS & BOOKBINDERS 117 N. 1ST ST.

Surveyed by R.D. Cooper - July 1909

John H. Lewis - State Engineer


Examined July 14, 1909.

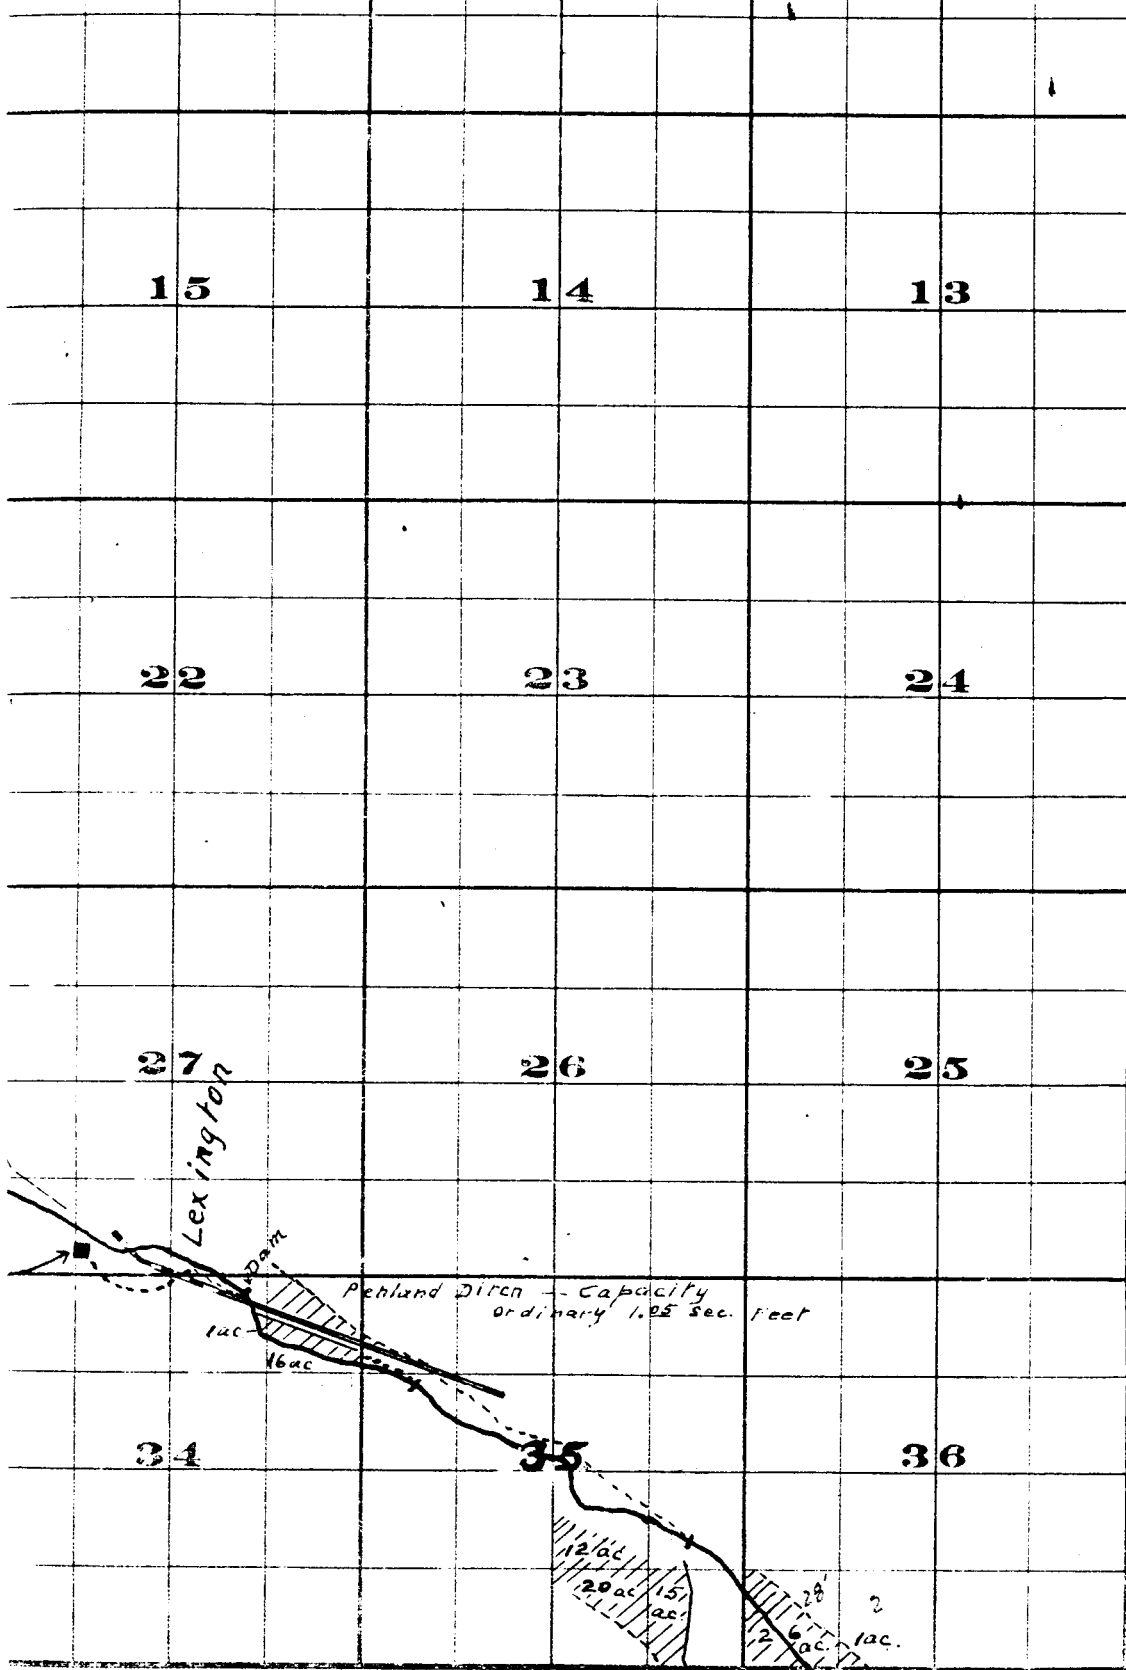

FROM OFFICE OF THE STATE ENGINEER, SALEM, OREGON

*Willow Creek Adjudication.*

TOWN

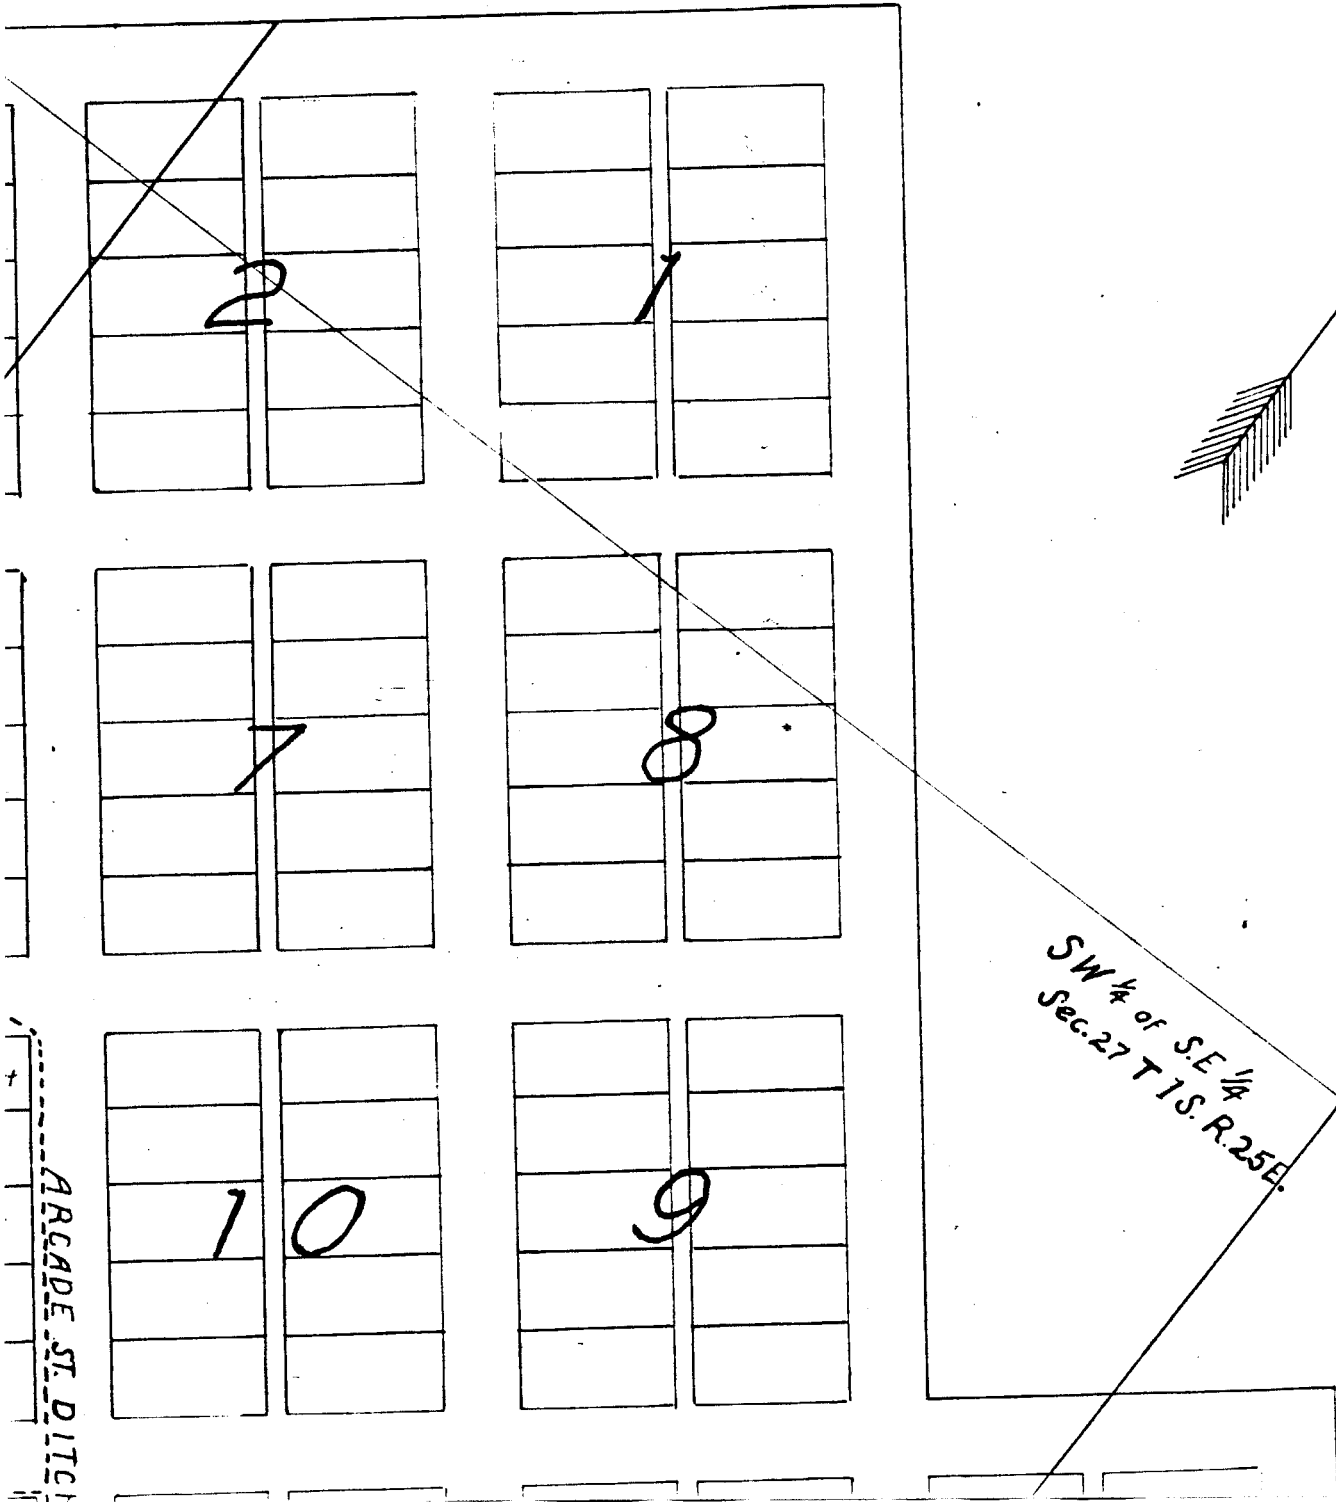

# LEXINGTON

2	1

2	2

4	

3	

Sarah Booher	
Sarah Booher	Sarah Booher
Sarah Booher	Sarah Booher
Sarah Booher	Sarah Booher
Sarah Booher	Sarah Booher

Ruth Barnett	
Ruth Barnett	WE Pointer

JM White	
JM White	

	Mrs. Boothby
	Mrs. Boothby
2	

Joe Eskelson	Mrs. C.A. Bengt
Joe Eskelson	W.R. Monkers
Joe Eskelson	W.R. Monkers
Joe Eskelson	W.R. Monkers
Joe Eskelson	W.R. Monkers

WE Leach	WG Scott
Breeding	WG Scott
E.A. Bolch Trustee for Congregational Church	WG Scott
	Mrs. Beymer
	Mrs. Beymer

Mill Race

Ellis

John

ARCADE ST. DITCH

John



1 Lot = 1/6 Acre

Note - Lots in Which Names Are Shown Are Irrigated

John H. Lewis - State Engineer

Examined J.

7	

8	

10	

9	

SW 1/4 of SE 1/4  
Sec. 27 T 1 S. R. 25 E.

ARCADE ST. DITCH

John McMillion	
John McMillion	
John McMillion	5
John McMillion	
John McMillion	

J.E. Gentry	A.M. Zink
J.E. Gentry	A.M. Zink
1	6
	F. Beymer
	W.F. Barnett
	W.F. Barnett

Peter McCabe	E.S. Duran
Peter McCabe	E.S. Duran
Peter McCabe	E.S. Duran
W.F. Barnett	E.S. Duran

1	8
Mrs. Beymer	
Mrs. Beymer	

	Frank Parker
W.B. McAllister	Roy McAllister
W.B. McAllister	7
Mrs. S.J. Boothby	E.W. Moyers
Mrs. S.J. Boothby	E.W. Moyers

PENLAND DITCH

10	1
9	2
8	3
7	4
6	5

All lots numbered the same

Scale 150 Ft. = 1 in

Lexington.

1 S. 25 E.

mined July 14, 1909.