


NO. 304. TOWNSHIP PLAT.


Township No. 14 S

Range No. 11 E

Meridian

Sketch of Griffiths Ditch.

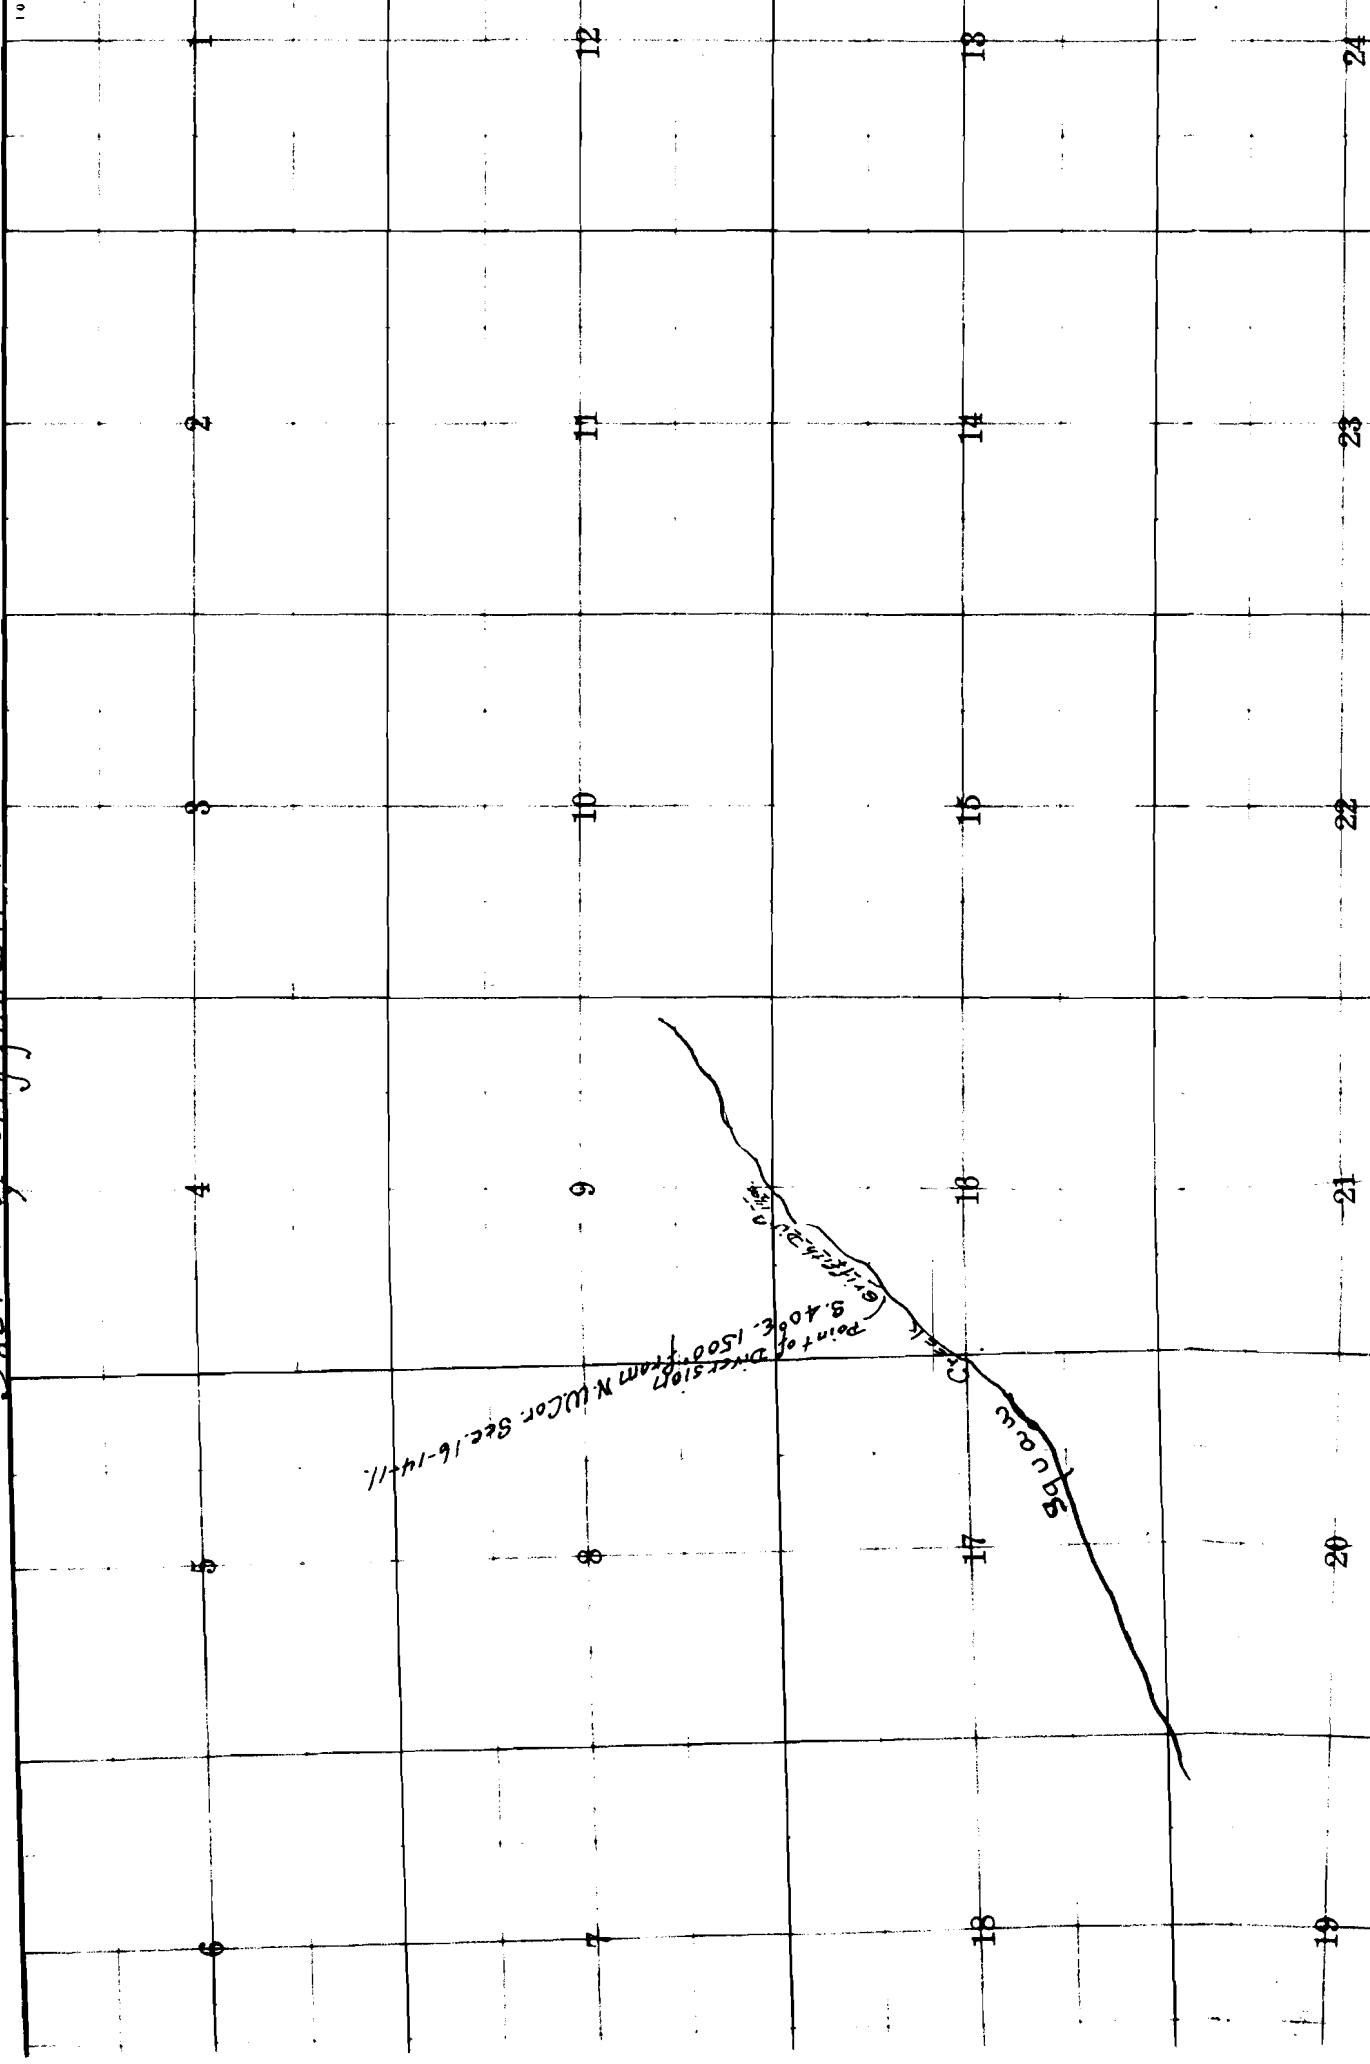

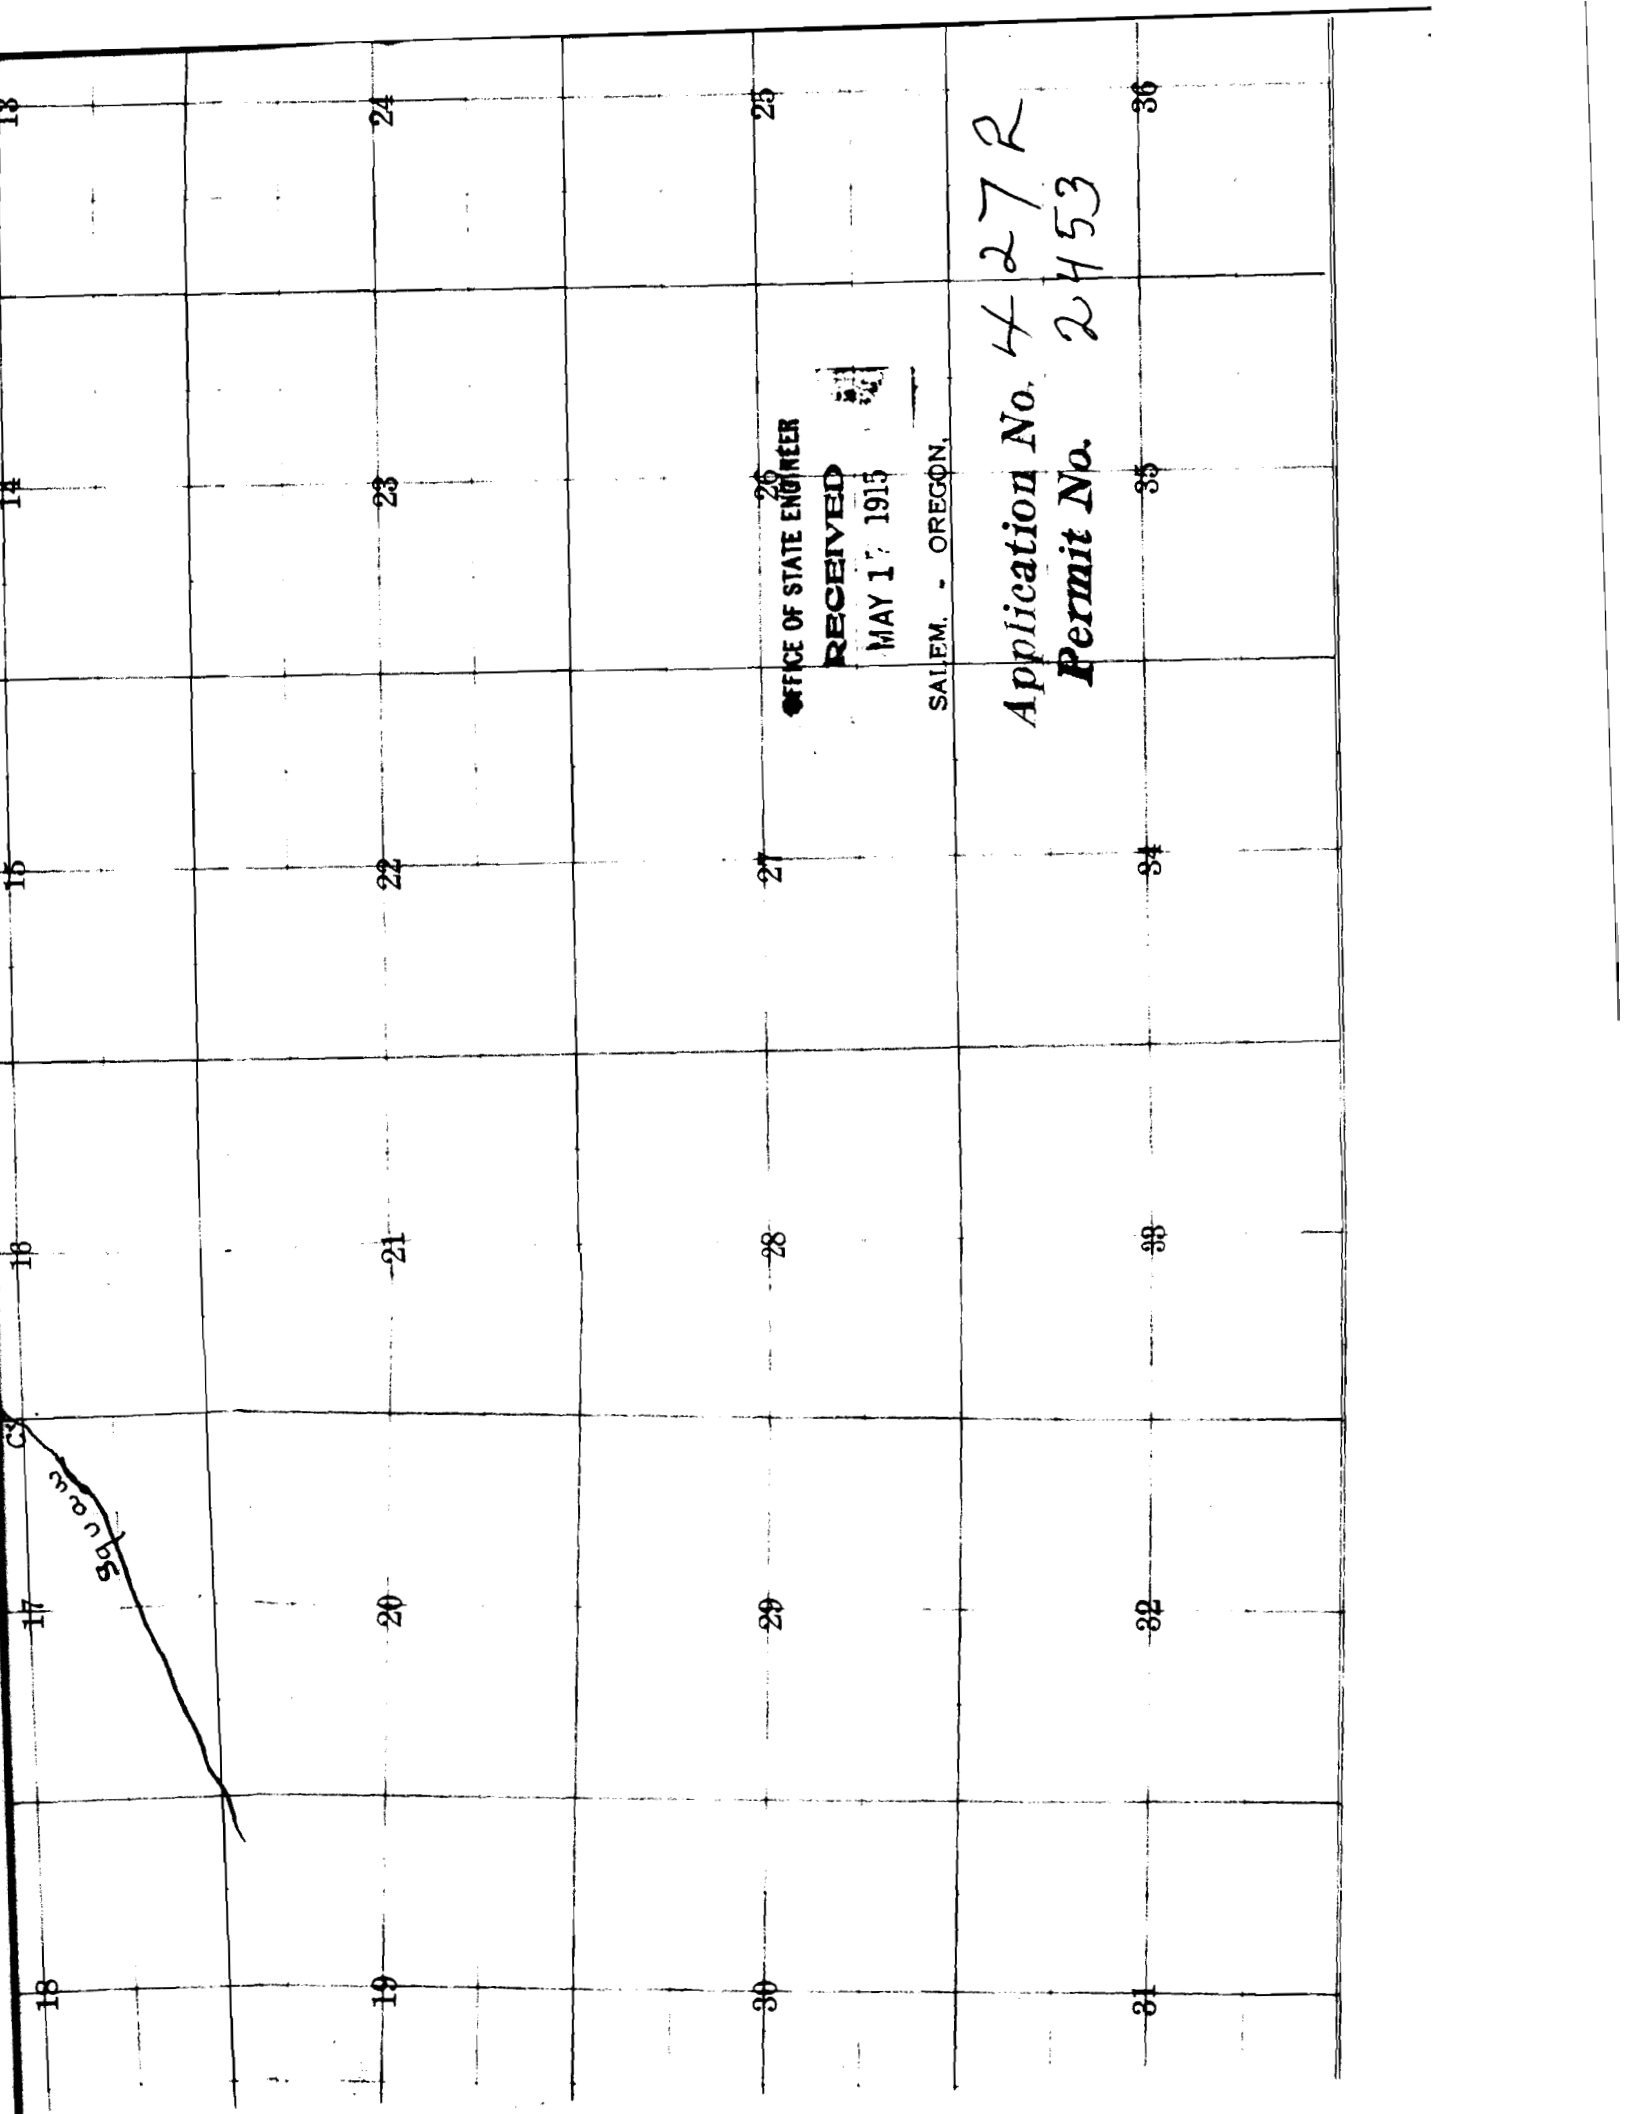

Salem

OFFICE OF STATE ENGINEER  
**RECEIVED**  
MAY 17 1915  
SALEM, - OREGON.

Application No. 427R  
Permit No. 2453