


T.5S.R.5W.W.M.

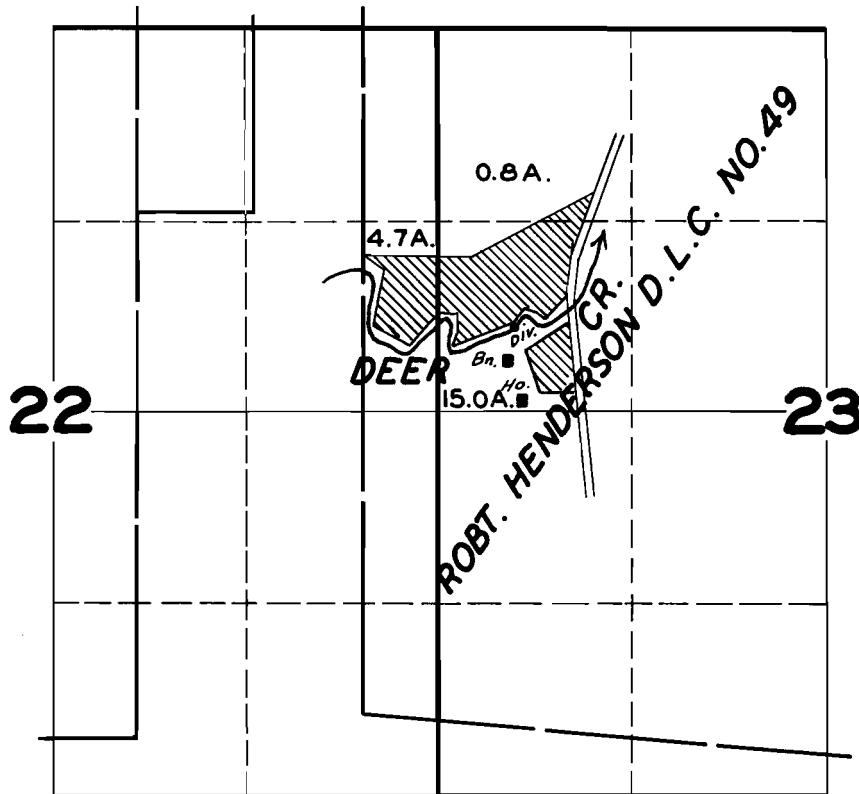

FINAL PROOF SURVEY

UNDER

Application No. **19979** Permit No. **15545**

IN NAME OF

L.A. COURTEMANCHE & LOUIS COURTEMANCHE, JR.

Surveyed **JUNE 10 1945**, by **JAS. E. BUNNELL**