


# T.5S.R.5W.W.M.

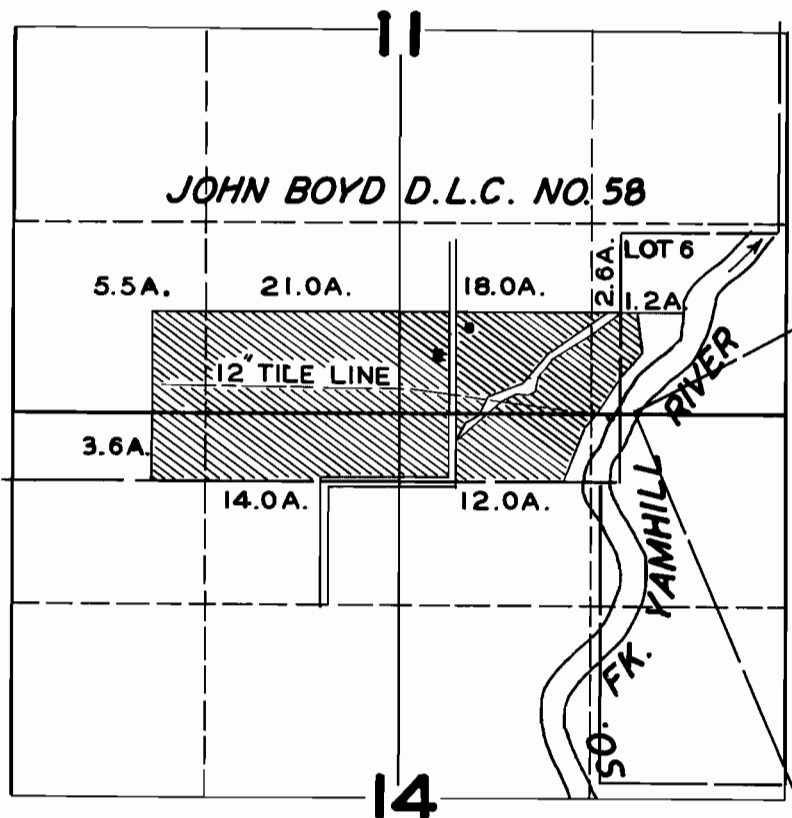

## FINAL PROOF SURVEY

UNDER

Application No. **19989** Permit No. **15553**

IN NAME OF

**CHESTER L. MULKEY**

Surveyed **JUNE 9**, 1948, by **JAS. E. BUNNELL**