


# T.7S.R.3W.W.M.

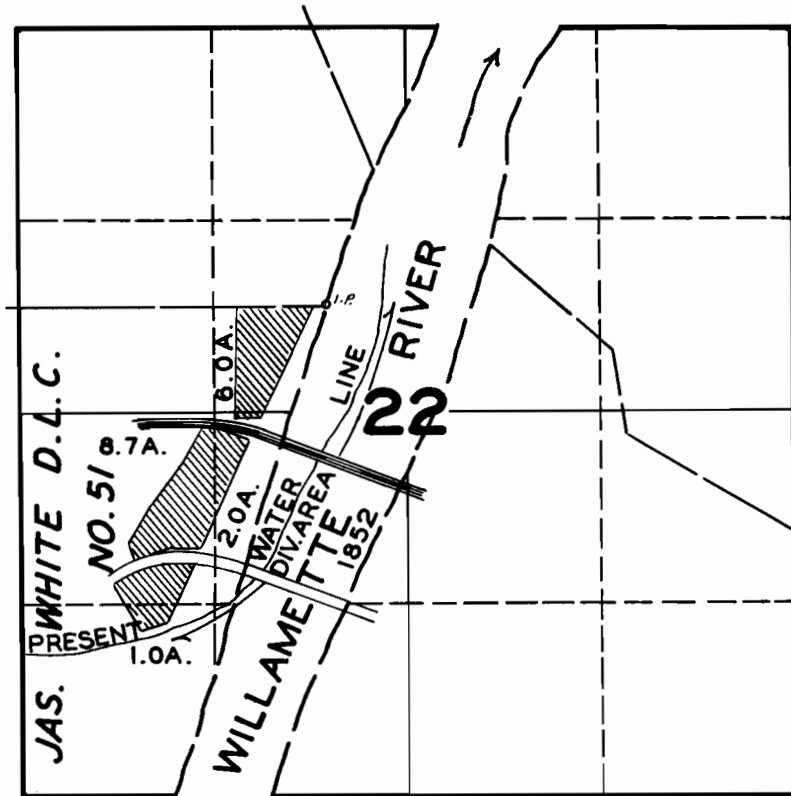

## FINAL PROOF SURVEY

UNDER

Application No. 19971 Permit No. 15570

IN NAME OF

GLENN O. LEWIS, SR.

Surveyed SEP. 13. 1947, by JAS. E. BUNNELL