


T.4S.R.10W.W.M.

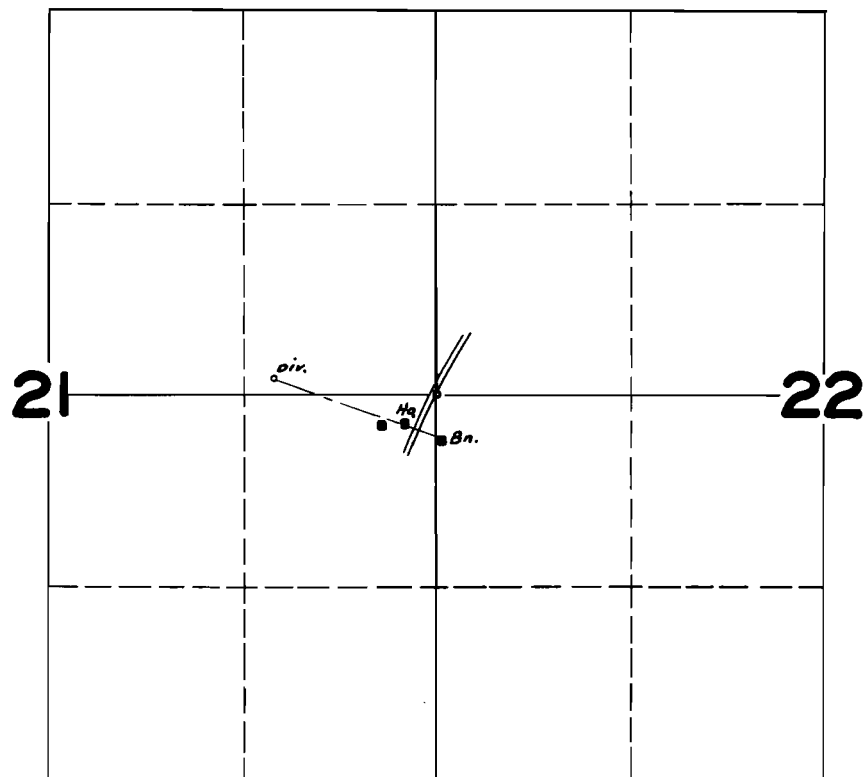

FINAL PROOF SURVEY UNDER

Application No. **20043** Permit No. **15610**
IN NAME OF

MATH M. GASS

Surveyed **AUG. 31**, 1948, by **JAS. E. BUNNELL**