


T.9S.R.3E.W.M.

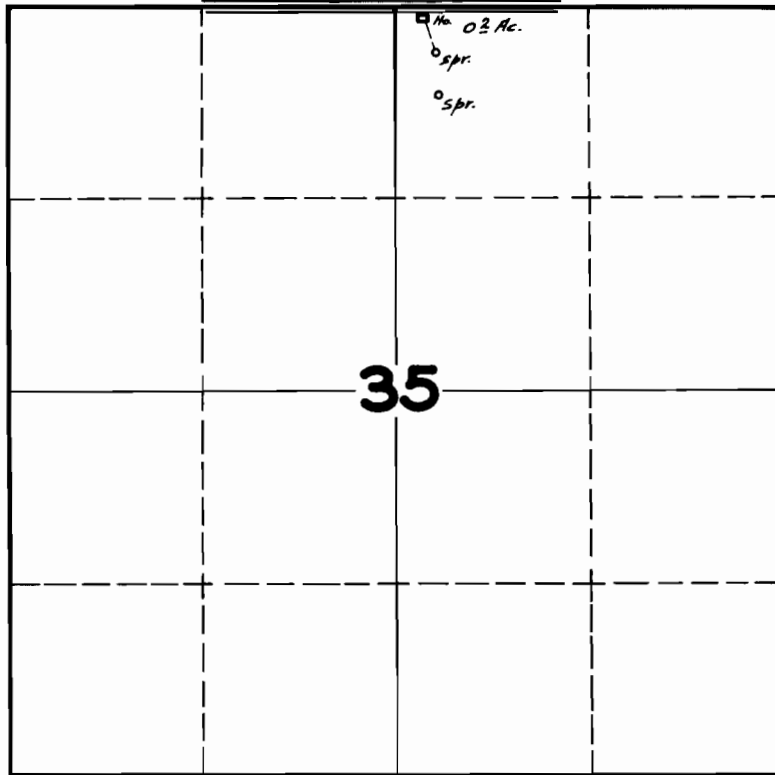

FINAL PROOF SURVEY UNDER

Application No. 20059 Permit No. 15624

IN NAME OF

R. C. BERRY

Surveyed MAY 26 1947, by JAS. E. BUNNELL