


# T.8S. R. 40E. W.M.

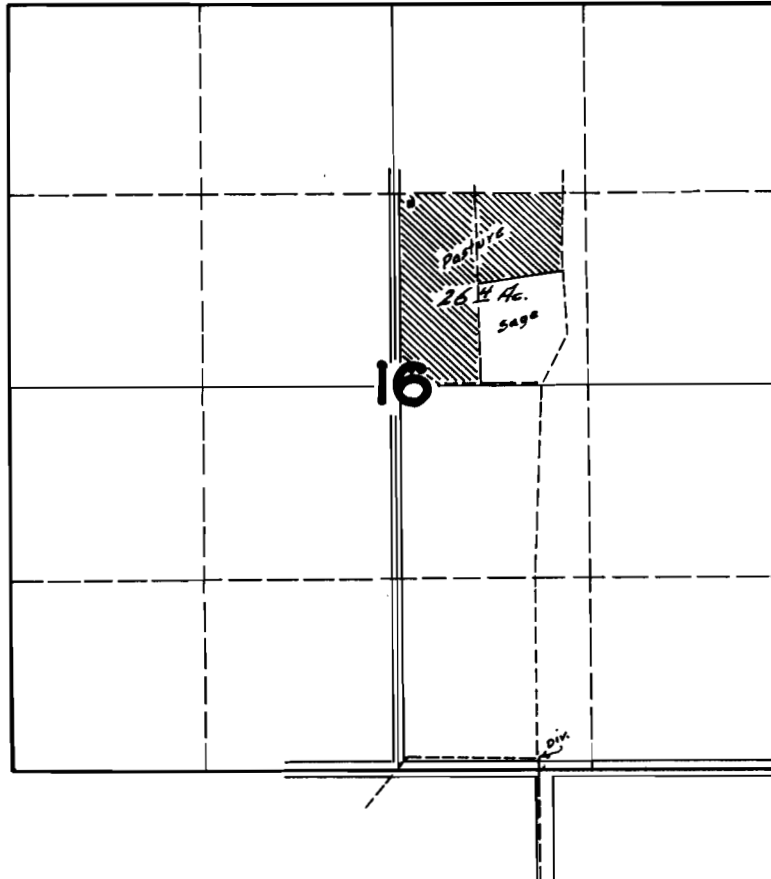

## FINAL PROOF SURVEY UNDER

Application No. 20103 Permit No. 15632

IN NAME OF

EMMA H. WARNER

Surveyed MAY 15 1947, by JAS. E. BUNNELL