


T. 3S. R. 40E. W. M.

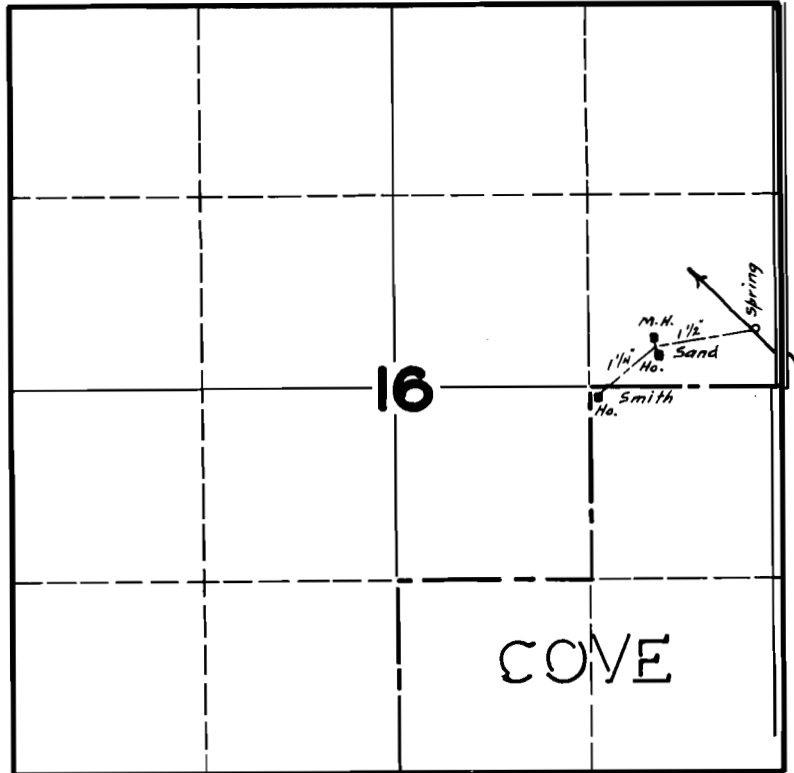

**FINAL PROOF SURVEY**

UNDER

Application No. 20135 Permit No. 15678

IN NAME OF

GLENN C. SAND

Surveyed JUNE 29 1946, by JAS. E. BUNNELL