


T.10S.R.6W.W.M.

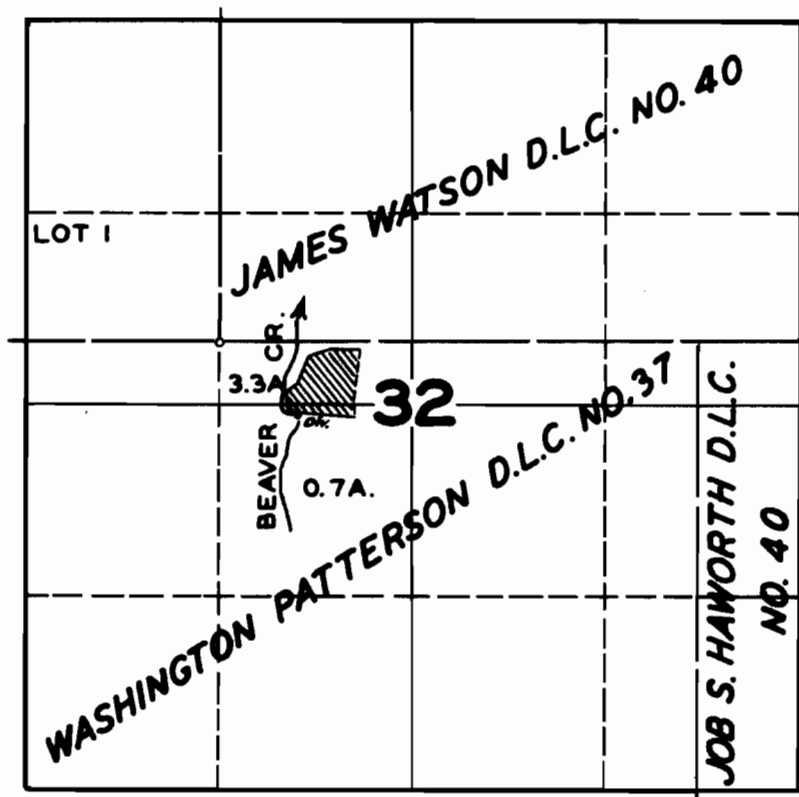

FINAL PROOF SURVEY
UNDER

Application No. **20152** Permit No. **15706**
IN NAME OF

HAROLD R. OLDS

Surveyed **JULY 9** 1948 by **JAS. E. BUNNELL**