


T.3S.R.2E.W.M.

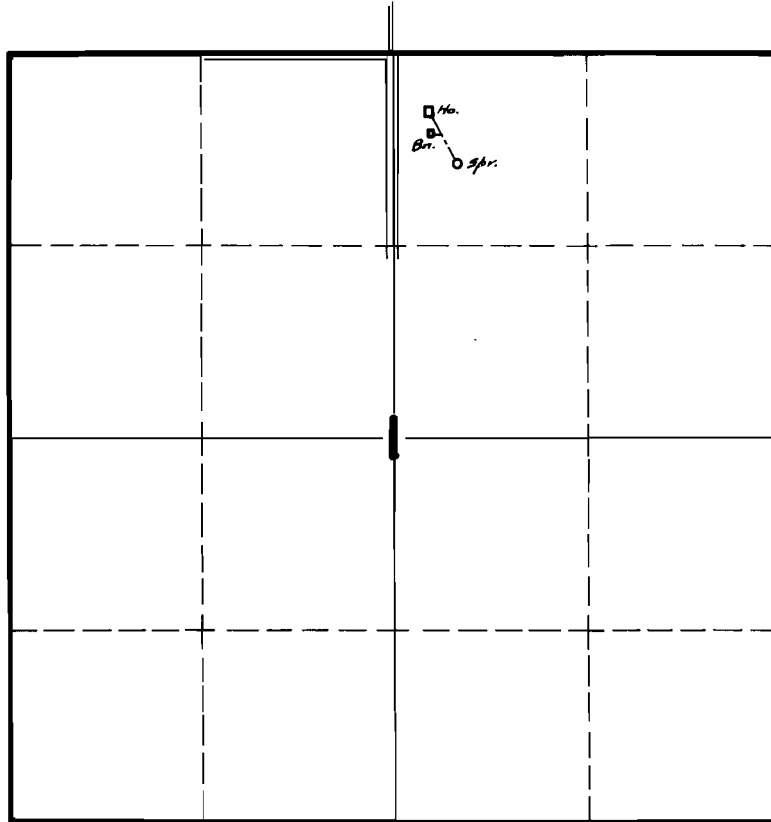

**FINAL PROOF SURVEY
UNDER**

Application No. 20169 Permit No. 15715

IN NAME OF

JOHN MARKLUND

Surveyed JUN. 18 1947, by JAS. E. BUNNELL