


T. IS. R. 3 W. W. M.

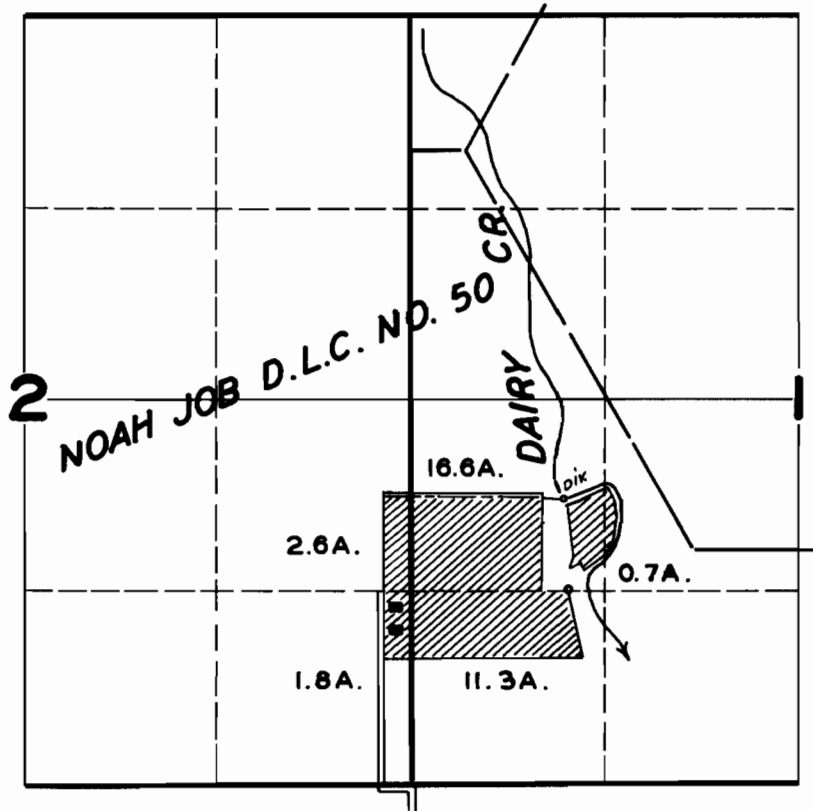

FINAL PROOF SURVEY UNDER

Application No. 20177 Permit No. 15736
IN NAME OF

CHESTER BRIDGES

Surveyed MAY 20 1948, by JAS. E. BUNNELL