


T. 1N. R. 40E. W. M.

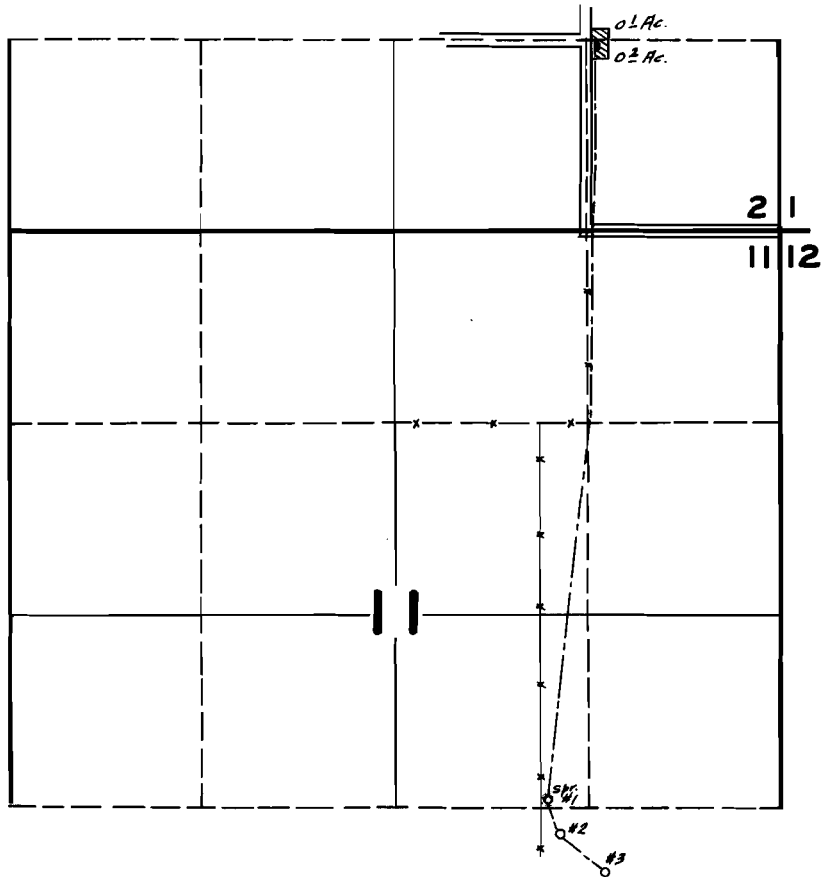

**FINAL PROOF SURVEY
UNDER**

Application No. 20184 Permit No. 15739

**IN NAME OF
HARSLEY A. COE**

Surveyed MAY 14, 1947, by JAS. E. BUNNELL