


T.4S.R.1W.W.M.

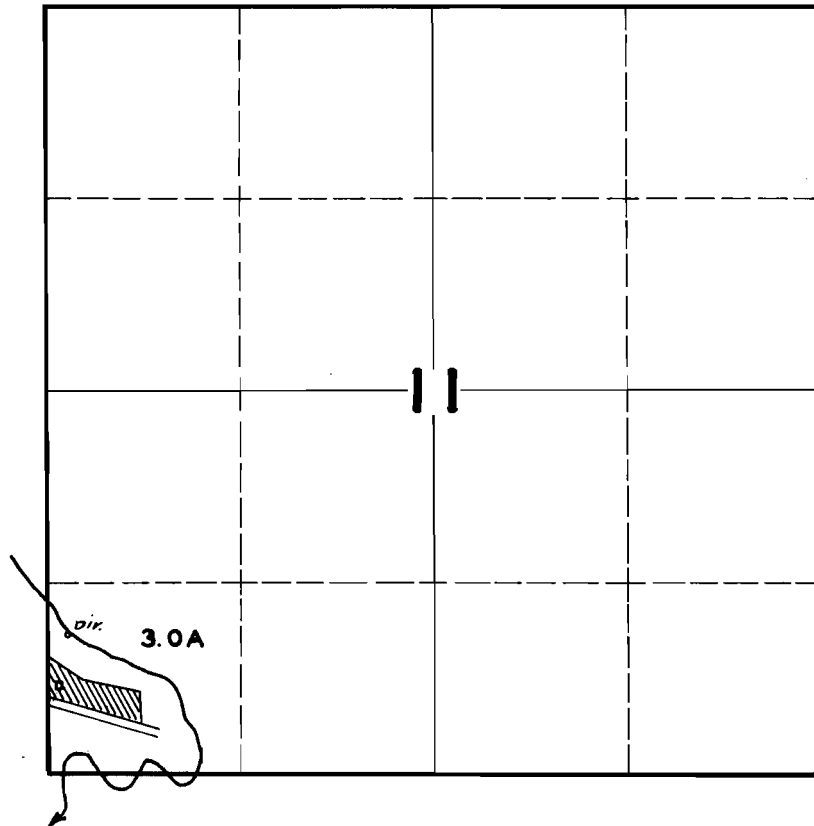

FINAL PROOF SURVEY UNDER

Application No. 20197 Permit No. 15749

IN NAME OF

SHERRILL FLEMING

Surveyed OCT. 23 1947, by JAS. E. BUNNELL