


T.4S.R.4W.W.M.

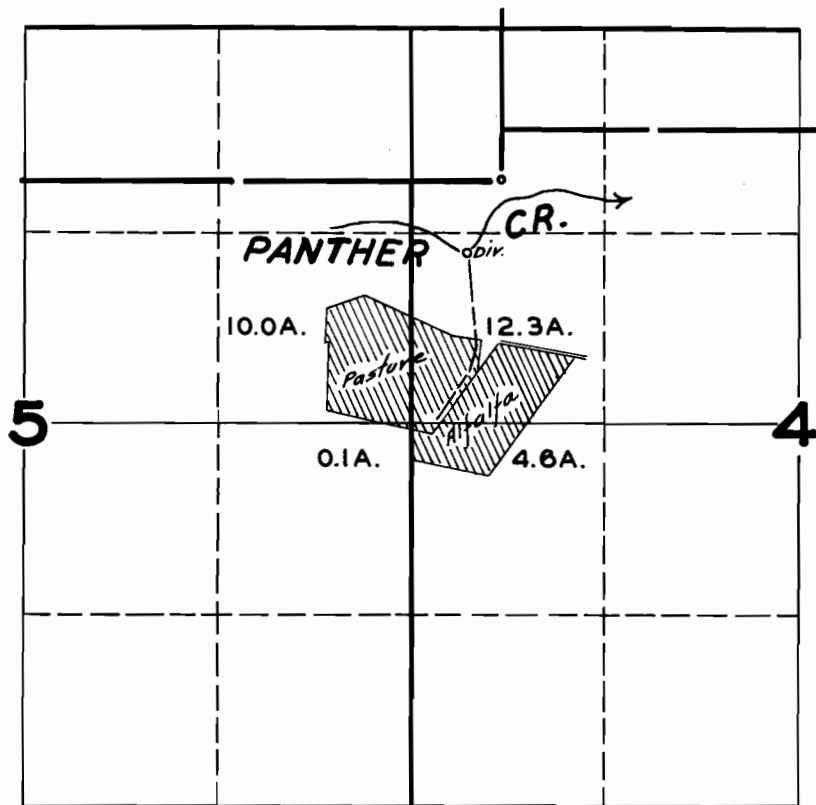

FINAL PROOF SURVEY

UNDER

Application No. **20200** Permit No. **15752**

IN NAME OF

GLEN S. MACY

Surveyed **AUG. 18, 1948**, by **JAS. E. BUNNELL**