


T. 2 S. R. 2 W. W. M.

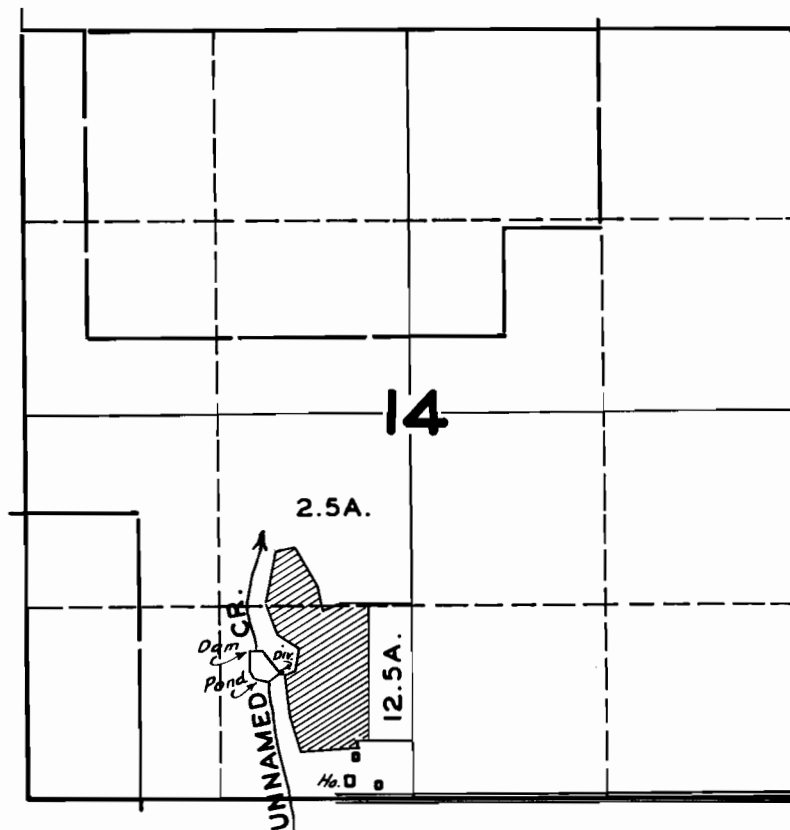

FINAL PROOF SURVEY UNDER

Application No. **20210** Permit No. **15761**

IN NAME OF

ARTHUR F. & BONNIE E. LIERMAN

Surveyed **OCT. 22 1947.** by **JAS. E. BUNNELL**