


T.5S.R.5W.W.M.

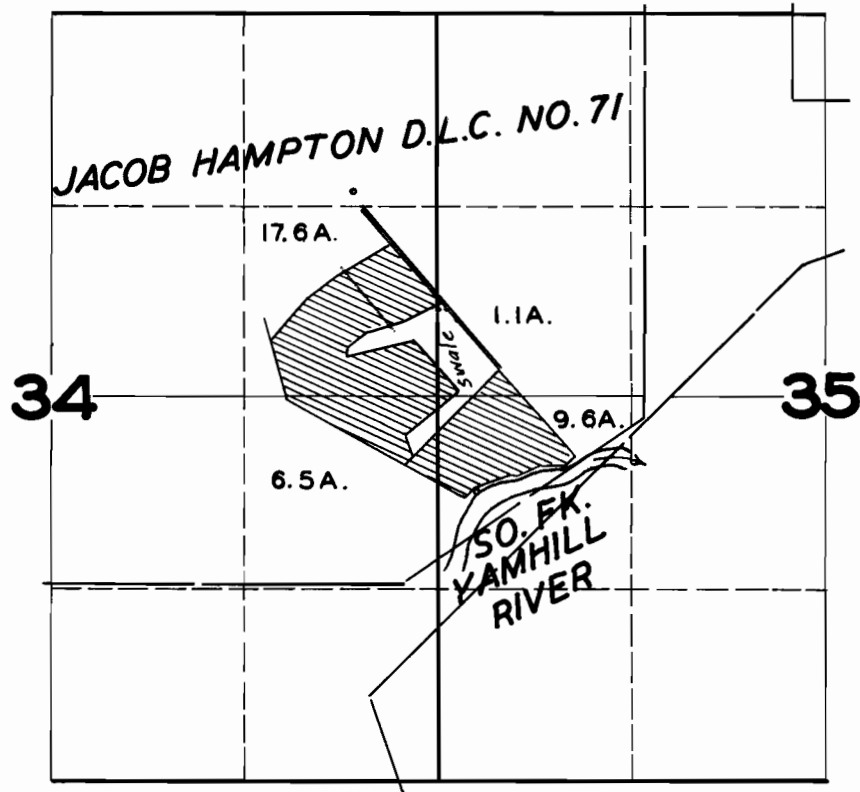

FINAL PROOF SURVEY UNDER

Application No. **20222** Permit No. **15807**
IN NAME OF

MERL C. BROWN

Surveyed **JUNE 9, 1948**, by **JAS. E. BUNNELL**