


T.2S.R.3E.W.M.

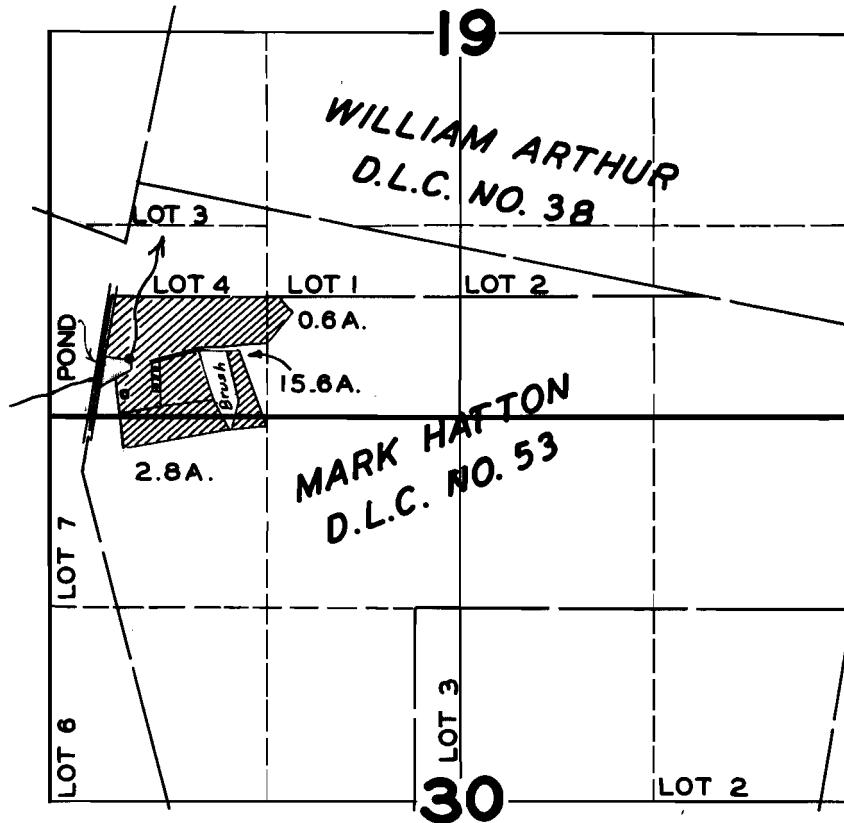

FINAL PROOF SURVEY UNDER

Application No. **20226** Permit No. **15808**
IN NAME OF

GEORGE W. CHAPPELL

Surveyed **SEP. 3** 1948, by **JAS. E. BUNNELL**