


T.2S.R.1E.W.M.

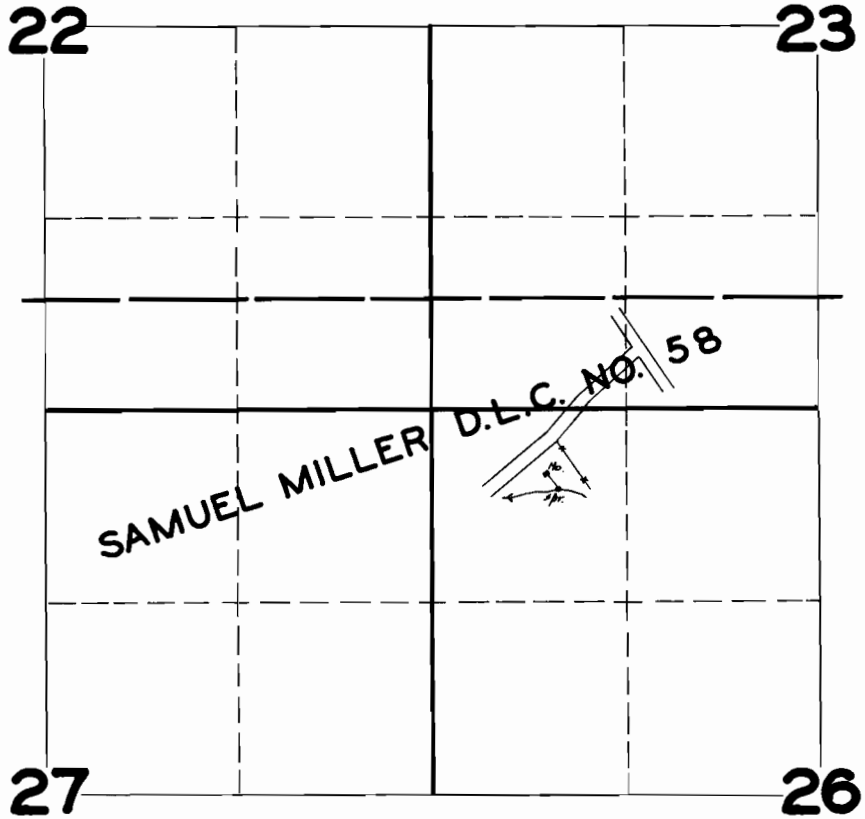

**FINAL PROOF SURVEY**  
UNDER

Application No. 20250 Permit No. 15811

IN NAME OF

E. E. HOLLAR

Surveyed SEP. 8 1947, by JAS. E. BUNNELL