


T.26S.R.14W.W.M.

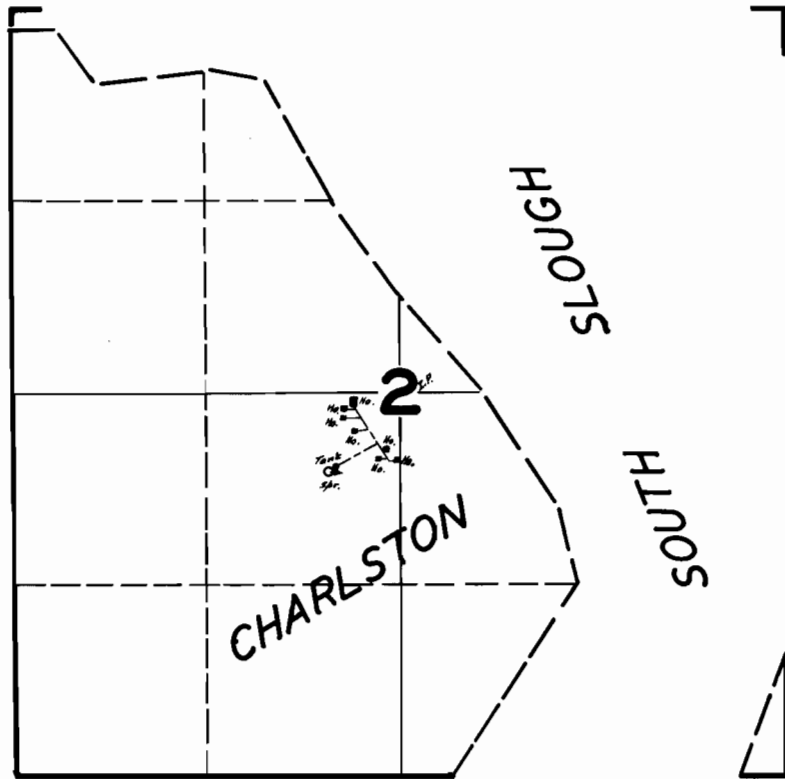

FINAL PROOF SURVEY
UNDER

Application No. 20302 Permit No. 15836

IN NAME OF

ROBERT H. NAGLE ET AL.

Surveyed JULY 20 1945 by [Signature]