


T.2S.R.2E.W.M.

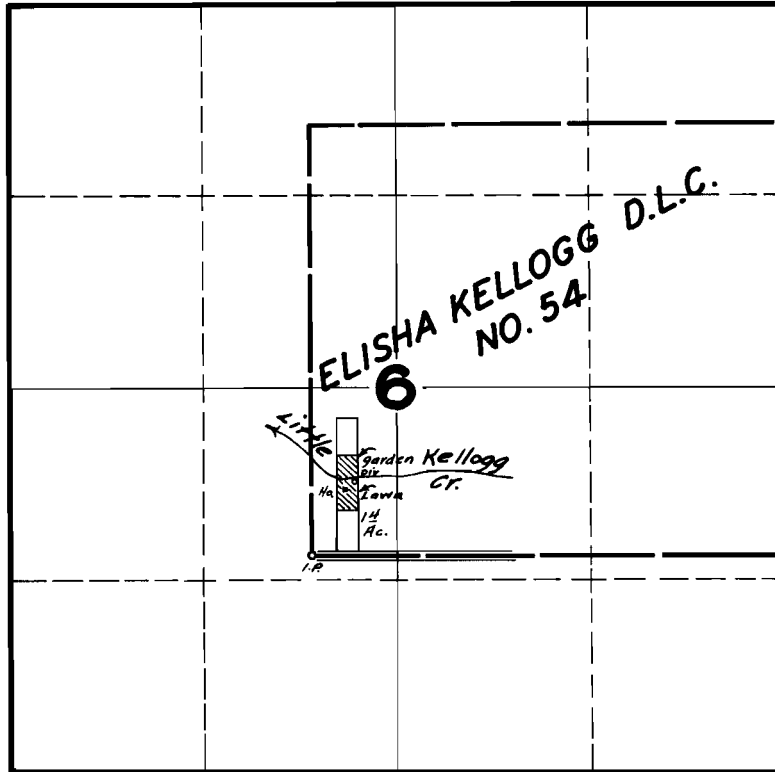

FINAL PROOF SURVEY
UNDER

Application No. 20331 Permit No. 15860
IN NAME OF
W.E. INGLE

Surveyed SEP. 8, 1947, by JAS. E. BUNNELL