


T.10S.R.6E.W.M.

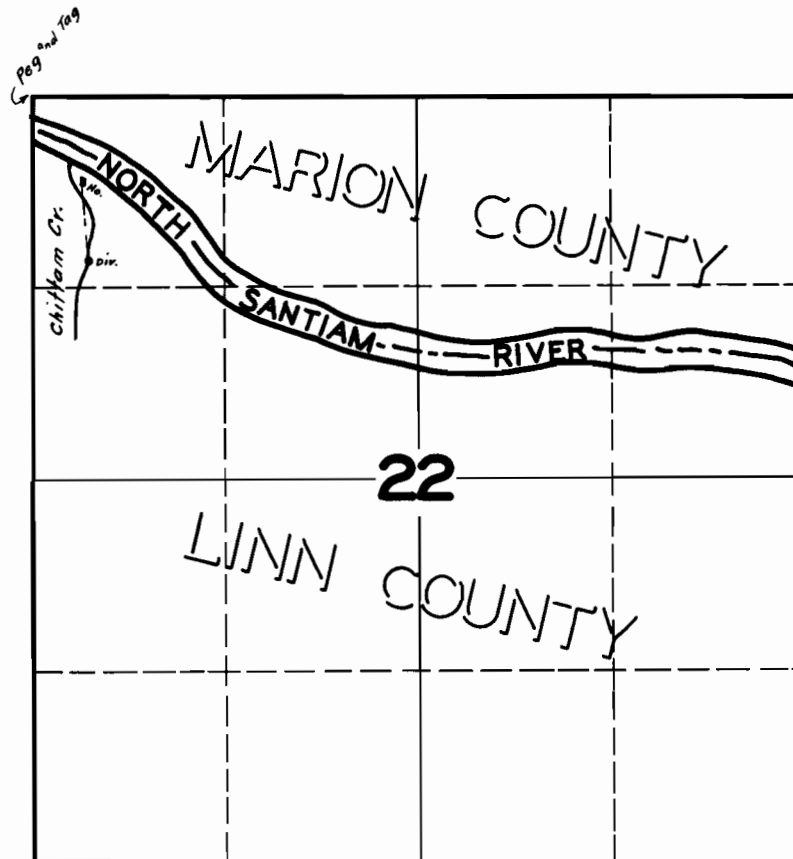

**FINAL PROOF SURVEY**  
UNDER

Application No. 20335 Permit No. 15863

IN NAME OF

EDW. M. SMITH

Surveyed MAY 3, 1946, by [Signature]