


**T.13S.R.7W.W.M.**

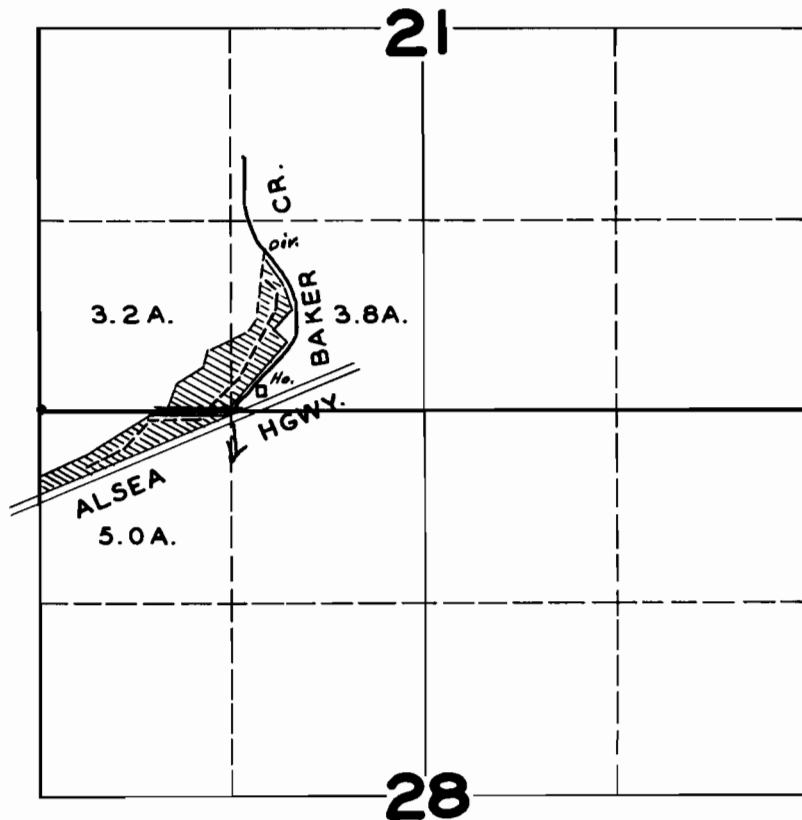

**FINAL PROOF SURVEY**  
UNDER

Application No. **20349** Permit No. **15873**  
IN NAME OF

**JOHN E. PORTER**

Surveyed **JUNE 29 1948**, by **JAS. E. BUNNELL**