


T. 5S. R. 3W. W.M.

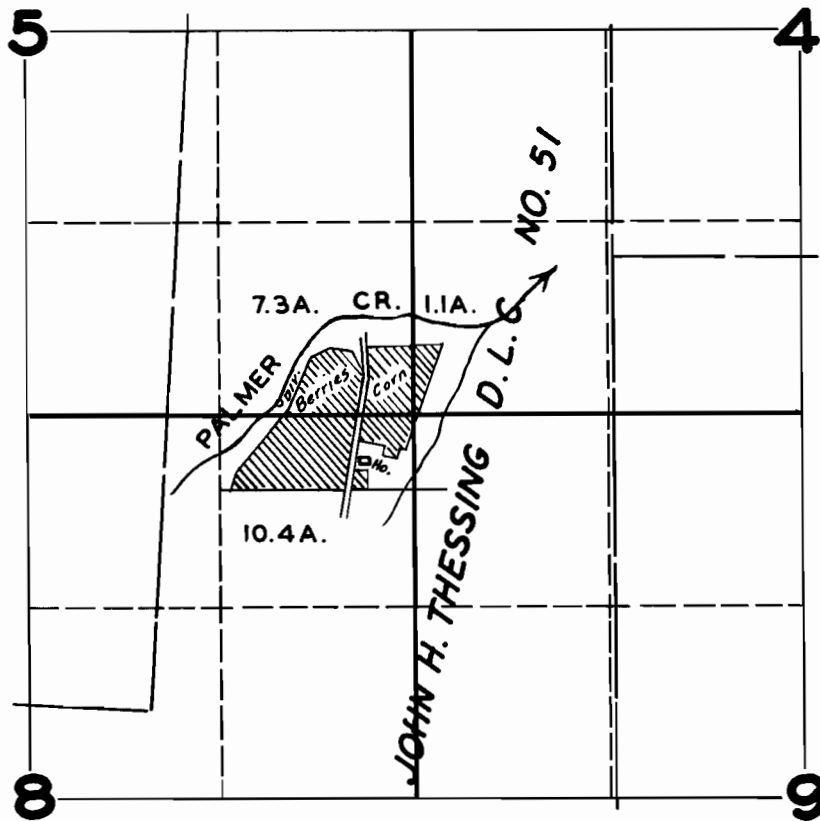

FINAL PROOF SURVEY

UNDER

Application No. 20353 Permit No. 15876

IN NAME OF

BUD R. BELL

Surveyed MAR. 20 1947, by JAS. E. BUNNELL