


T. 10S. R. 3W. W. M.

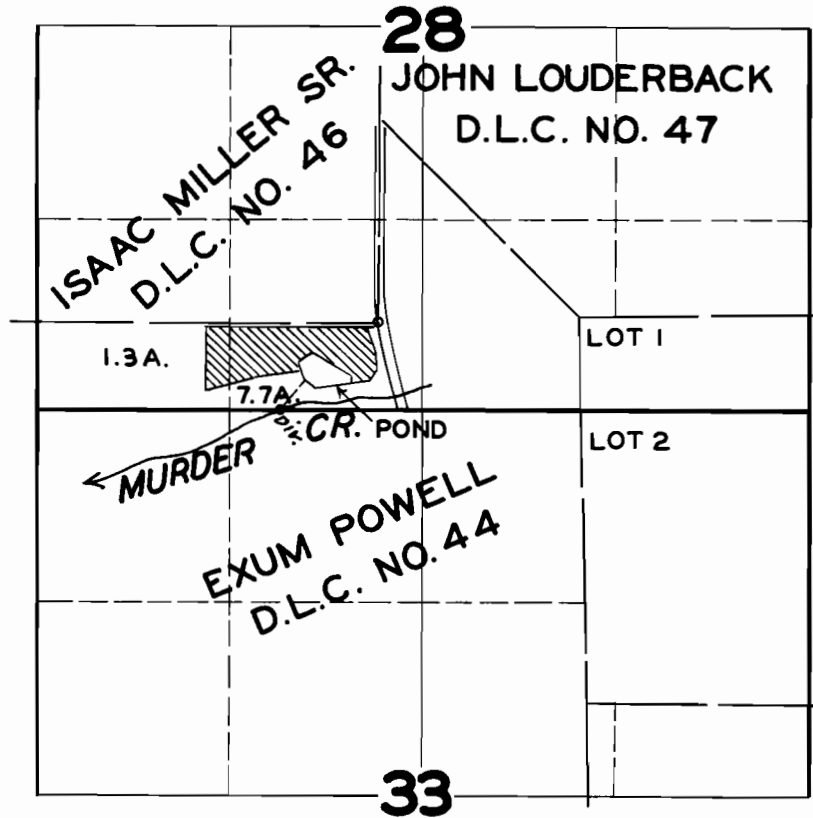

**FINAL PROOF SURVEY**  
UNDER

Application No. 20314 Permit No. 15915  
IN NAME OF

LINN BENTON MEMORIAL PARK ASSN.

Surveyed SEP. 23, 1948, by JAS. E. BUNNELL