


# T.3S. R.2W.W.M.

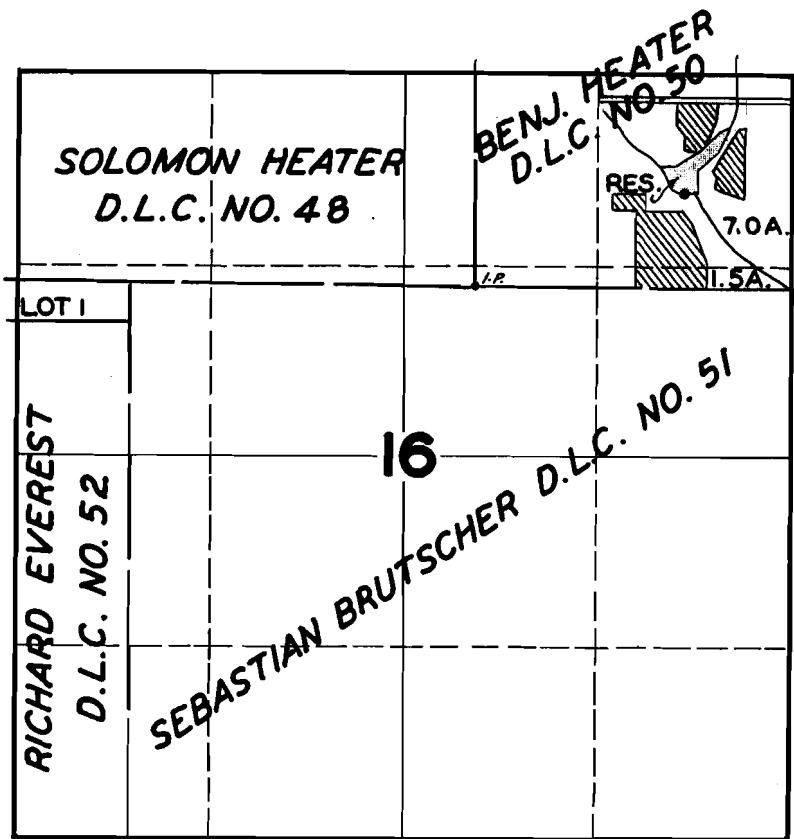

## FINAL PROOF SURVEY

UNDER

20417-R-21343 15944-R-832

Application No. 21344... Permit No. 16767.....

IN NAME OF

WOODROW DAVIS

Surveyed SEP. 9 1948, by JAS. E. BUNNELL