
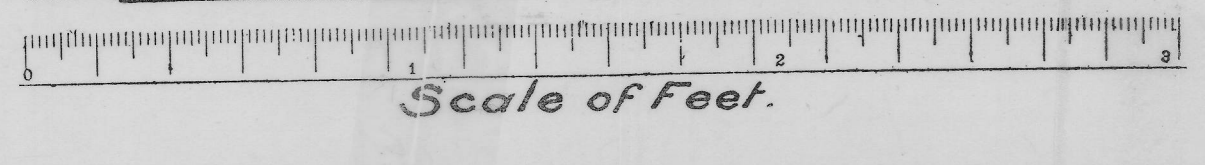


OFFICE OF STATE ENGINEER  
RECEIVED  
MAY 1 1915  
SALEM, OREGON

app 4228


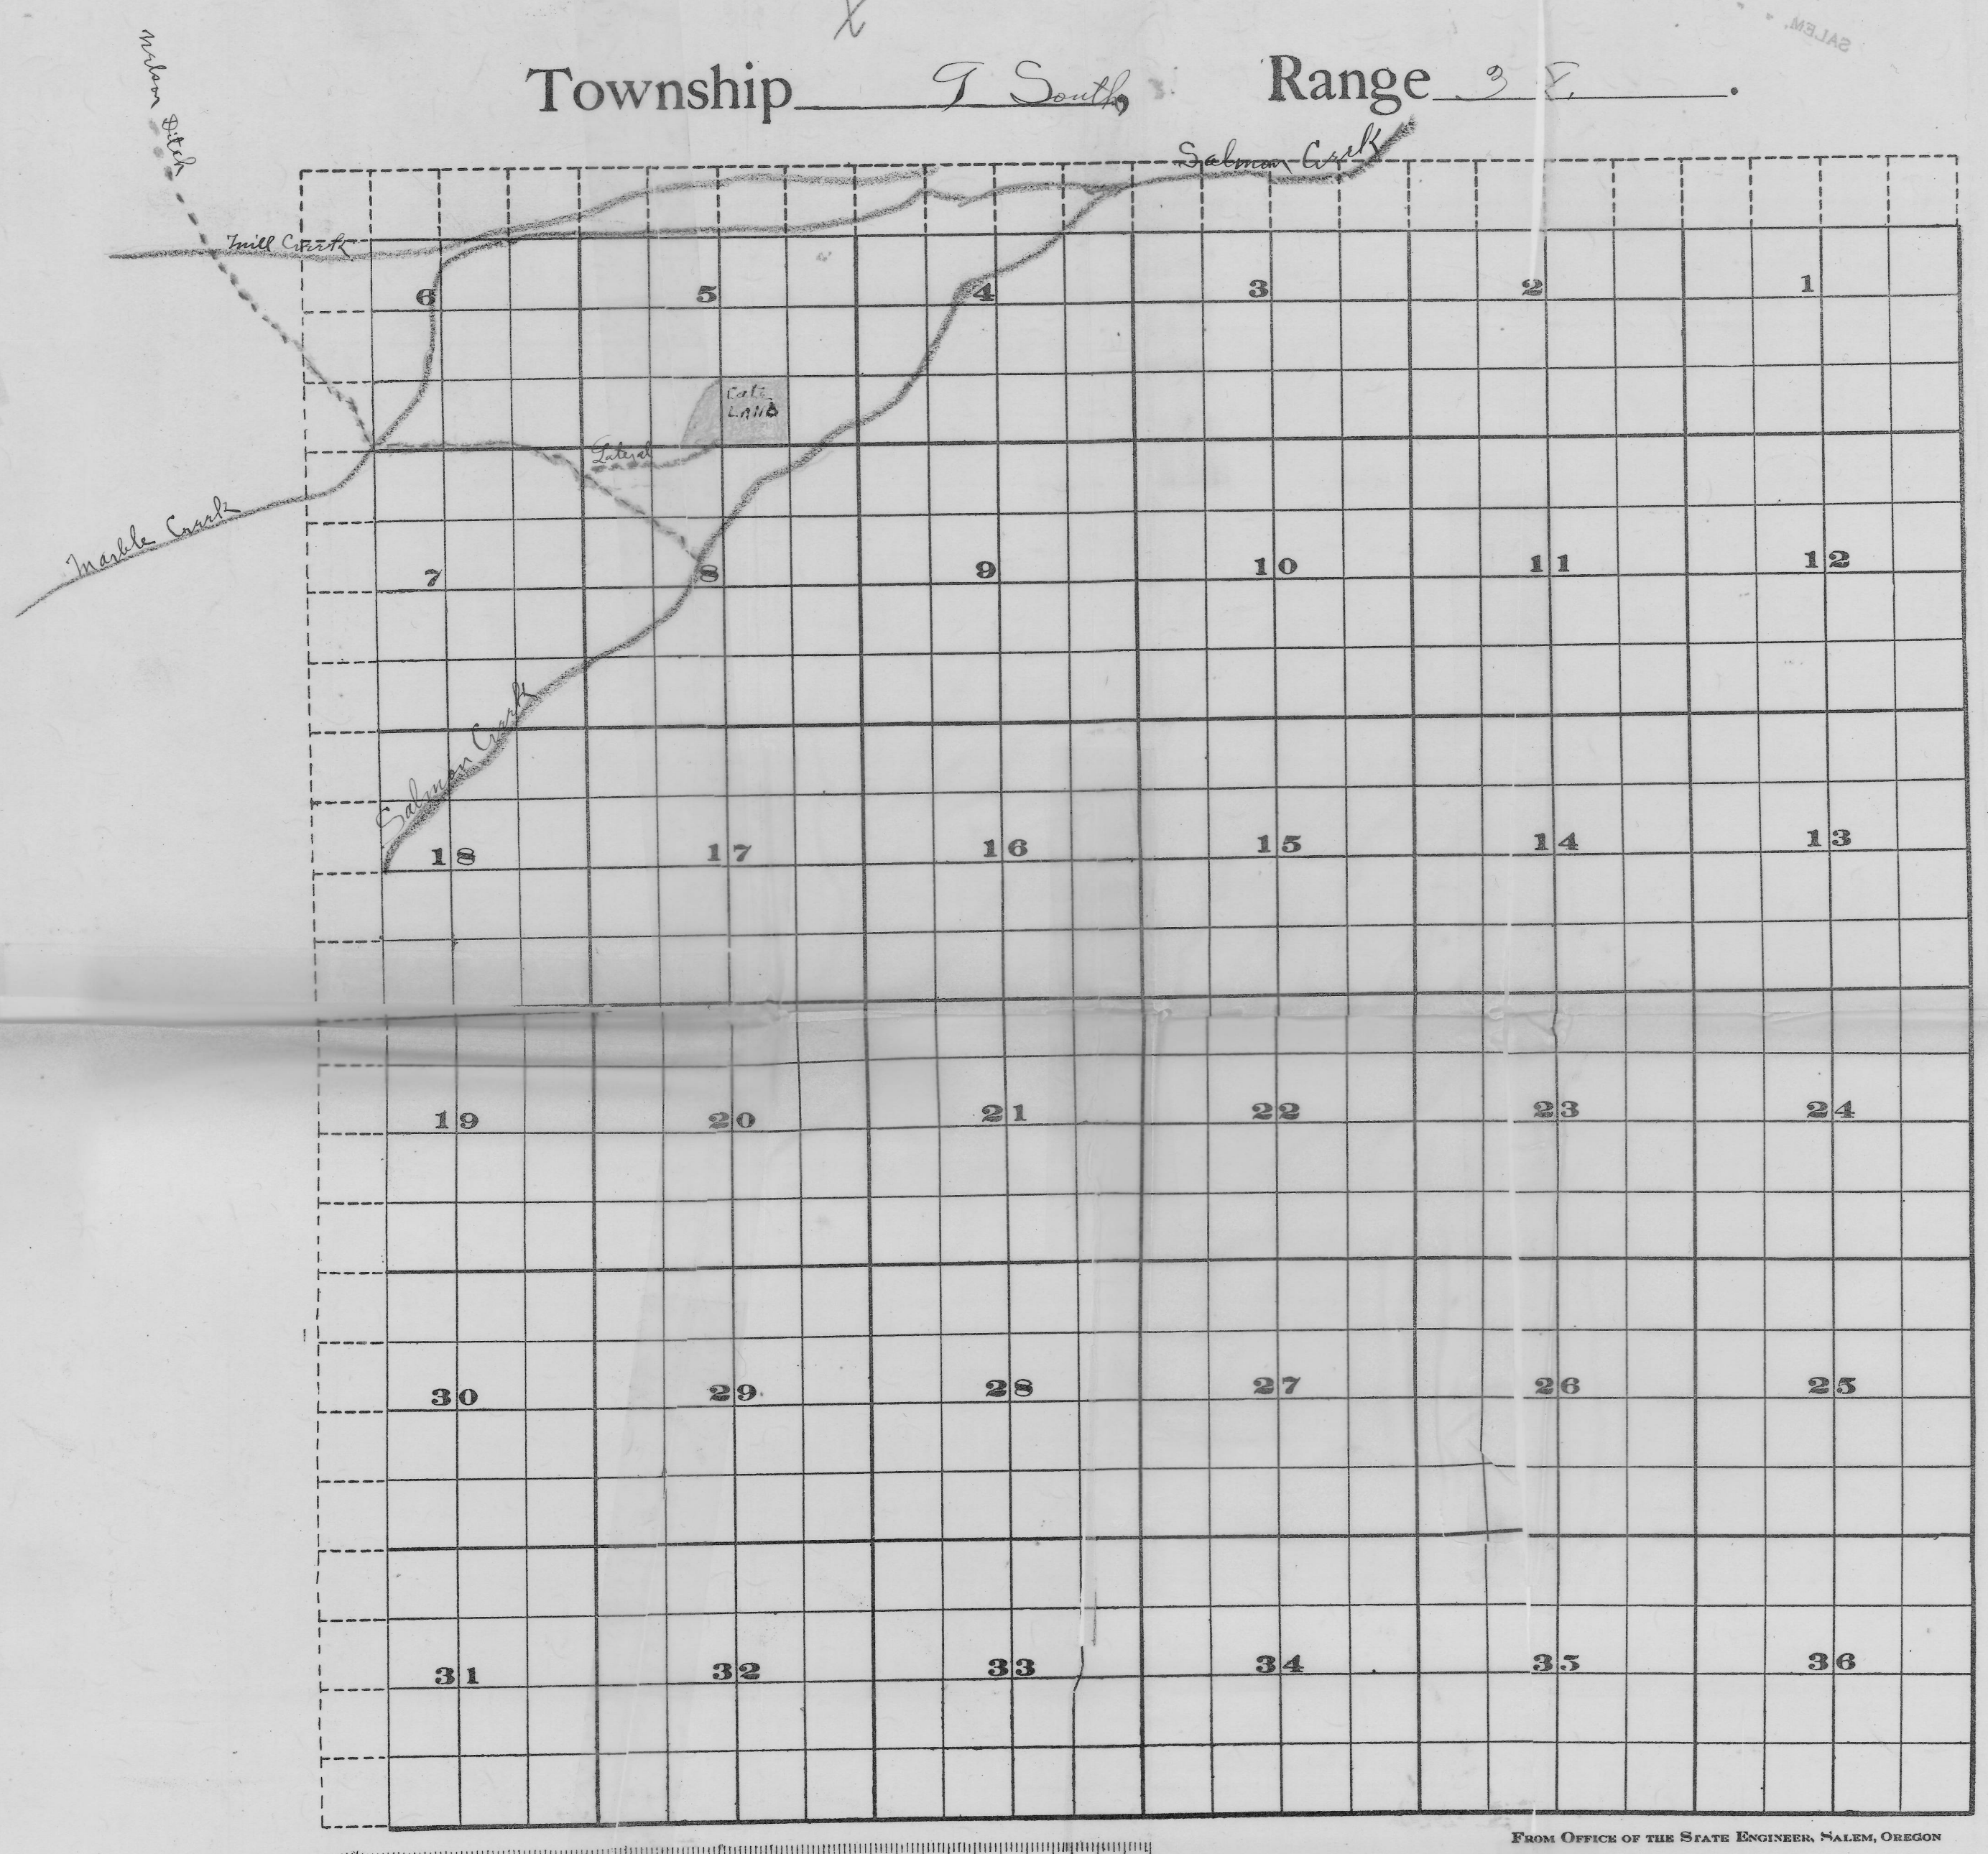

FROM OFFICE OF THE STATE ENGINEER, SALEM, OREGON

OFFICE OF STATE ENGINEER  
RECEIVED  
MAY 1 1915  
SALEM, OREGON

Application No. 4228  
Permit No. 2515

map covering application for water right, made by James Cate & A. Clara Cate, from Mill Creek and Marble Creek through the Mellon Ditch,

4558

4558