


**T.17S.R.1W.W.M.**

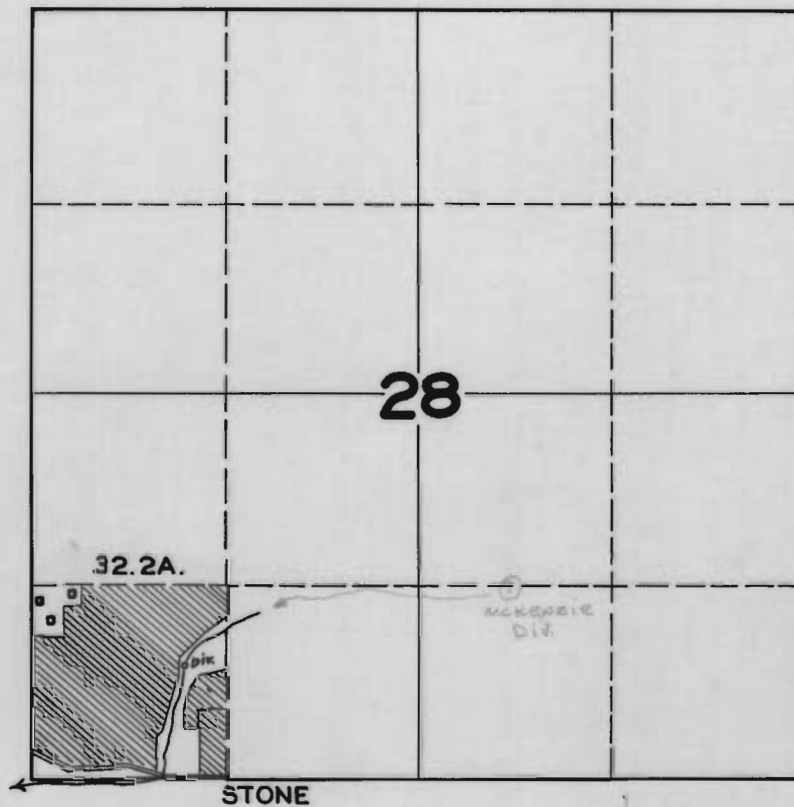

**FINAL PROOF SURVEY**  
UNDER

Application No. **20433** Permit No. **15954**  
IN NAME OF

**GEORGE M. EASTON & STELLA EASTON**

Surveyed **JUNE 17, 1948**, by **JAS. E. BUNNELL**