


T.8S.R.6W.W.M.

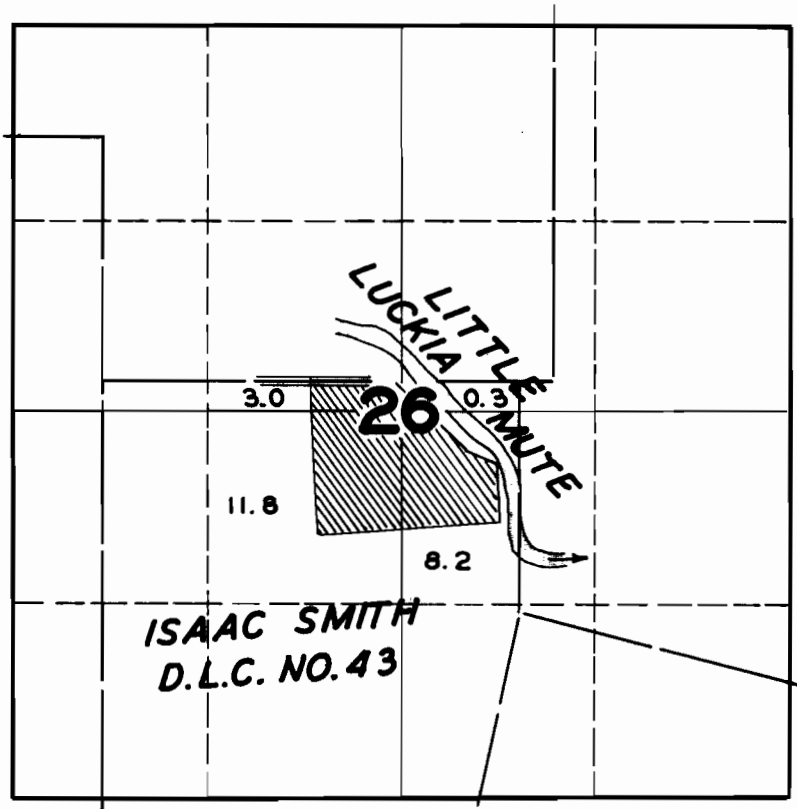

FINAL PROOF SURVEY

UNDER

Application No. 20439 Permit No. 15959

IN NAME OF

MRS. MABEL YOAKUM HILL

Surveyed APR. 12 1949, by JAS. E. BUNNELL