


T.5S. R.1E.W.M.

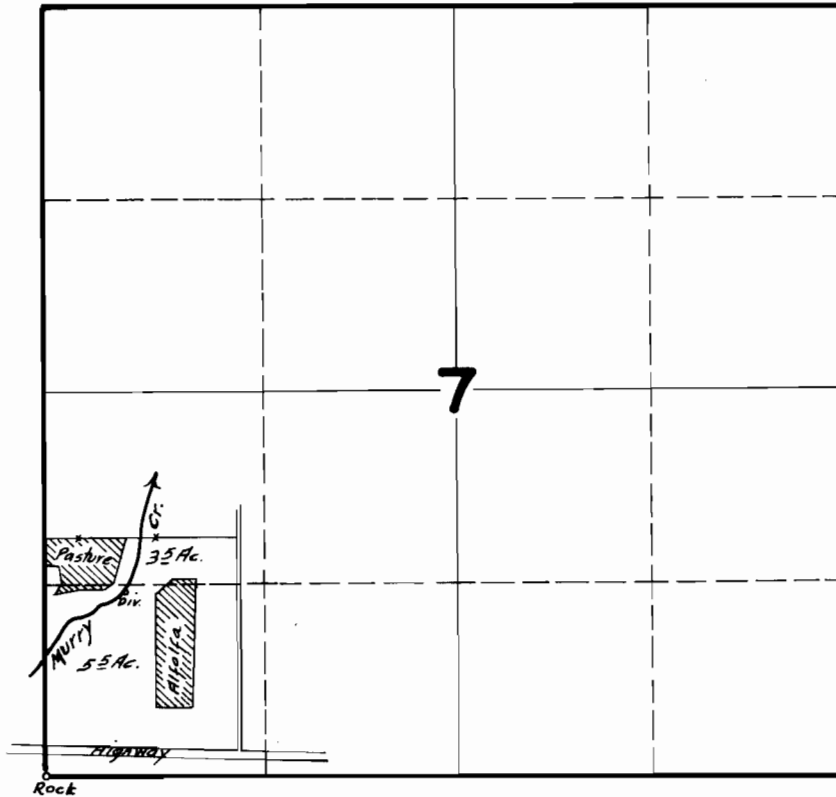

FINAL PROOF SURVEY UNDER

Application No. 20445 Permit No. 15964

IN NAME OF

MRS. DORTHY BOND

Surveyed OCT. 23 1947, by JAS. E. BUNNELL