


# T.4S.R.3W.W.M.

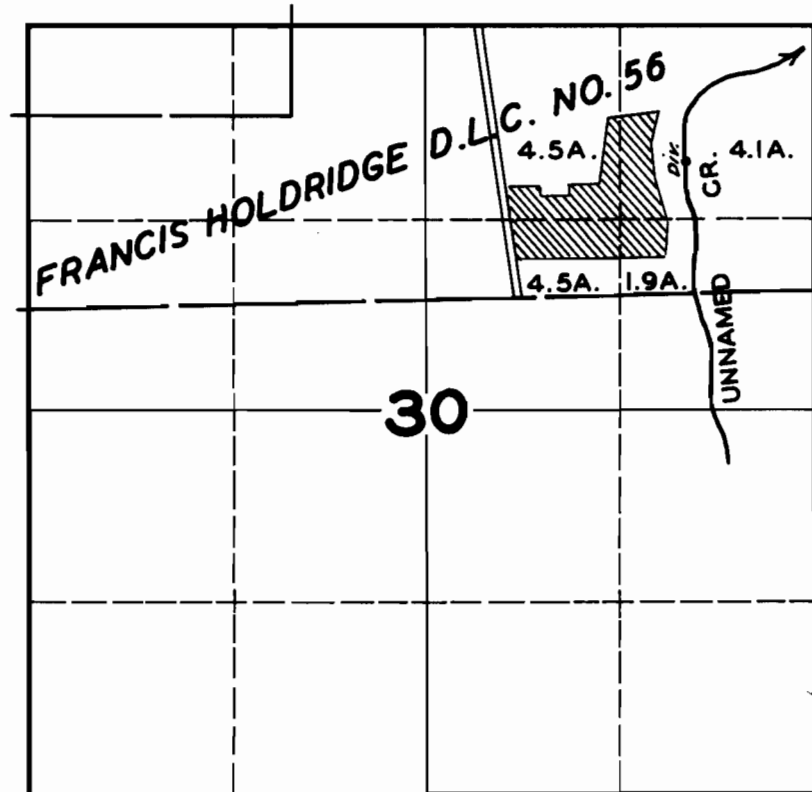

## FINAL PROOF SURVEY

UNDER

Application No. ~~20452~~ Permit No. ~~15969~~.....

IN NAME OF

~~.....~~ BEN AEBI ~~.....~~

Surveyed ~~MAY 14~~ 1948, by ~~JAS. E. BUNNELL~~