


T.6S.R.1W.W.M.

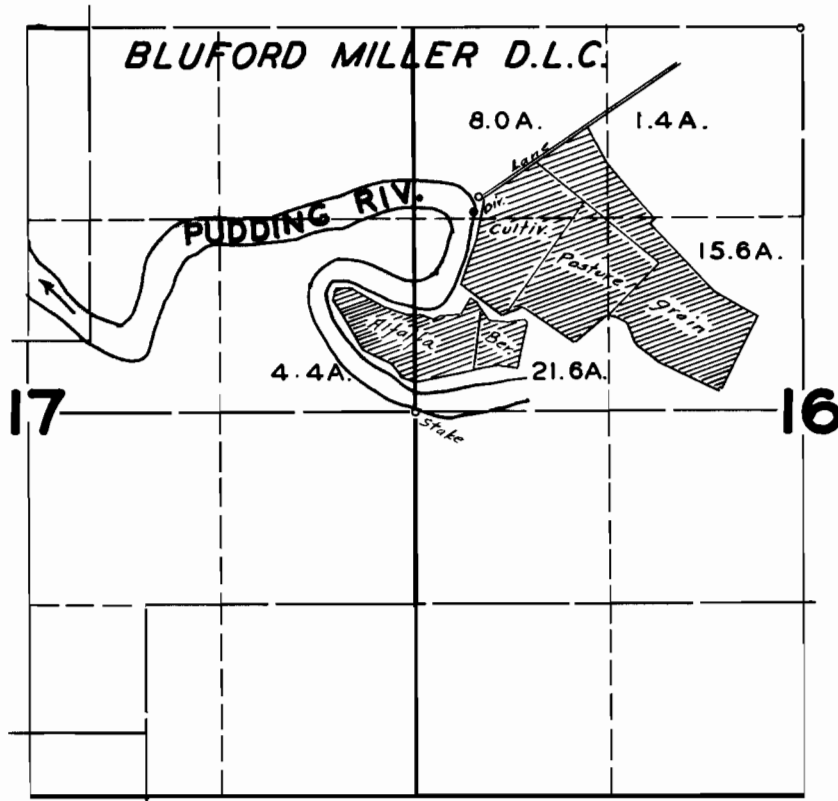

FINAL PROOF SURVEY

UNDER

Application No. 20469 Permit No. 15981

IN NAME OF

A. P. DUDA

Surveyed JUN. 25 1947, by JAS. E. BUNNELL