


T.2S.R.IW.W.M.

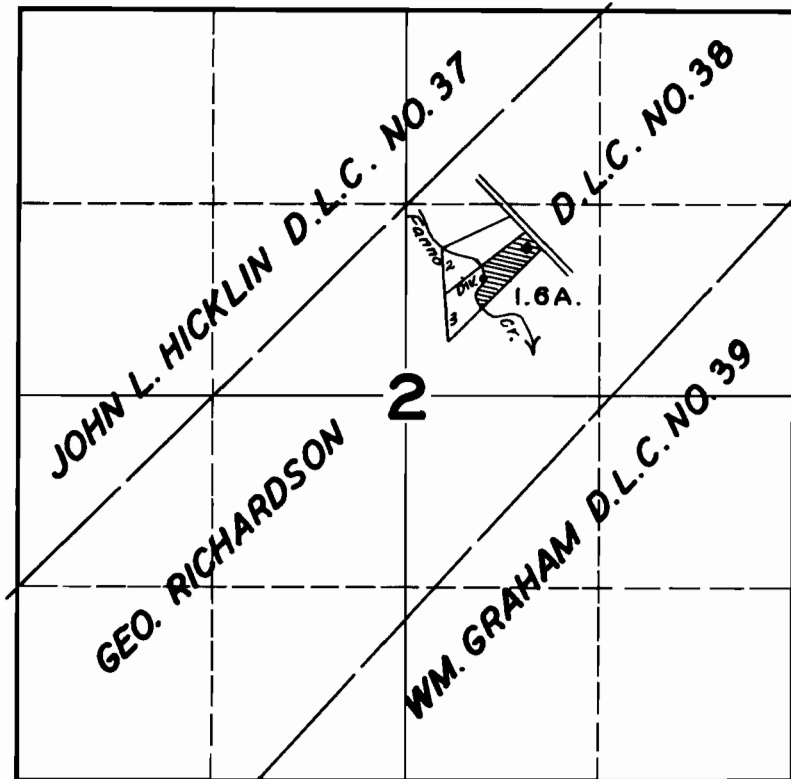

FINAL PROOF SURVEY

UNDER

Application No. 20509 Permit No. 16011.....

IN NAME OF

DANIEL F. MOOTER.....

Surveyed MAY 4... 1948, by JAS. E. BUNNELL