


T.41S.R.13W.W.M.

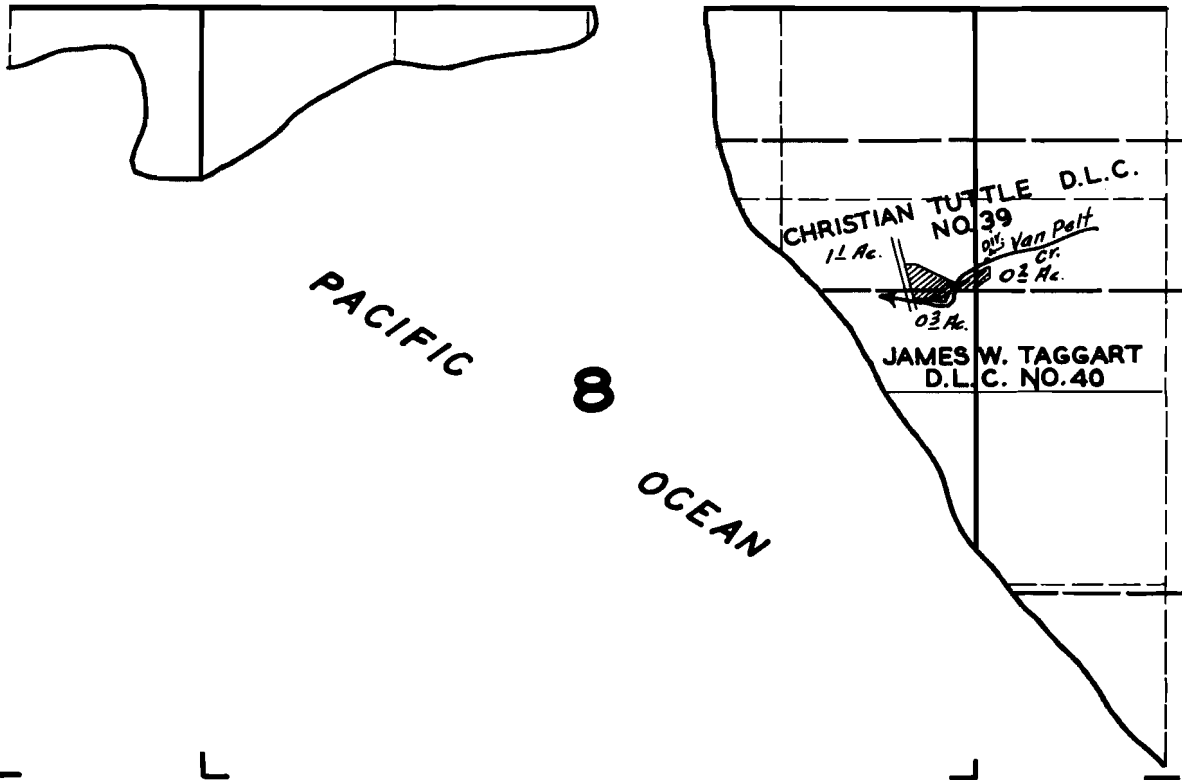

FINAL PROOF SURVEY

UNDER

Application No. 20516 Permit No. 16018

IN NAME OF

ANNIE LUCAS & LEO LUCAS

Surveyed JUL. 22 1947, by JAS. E. BUNNELL