


T.I.S. R.I.W.W.M.

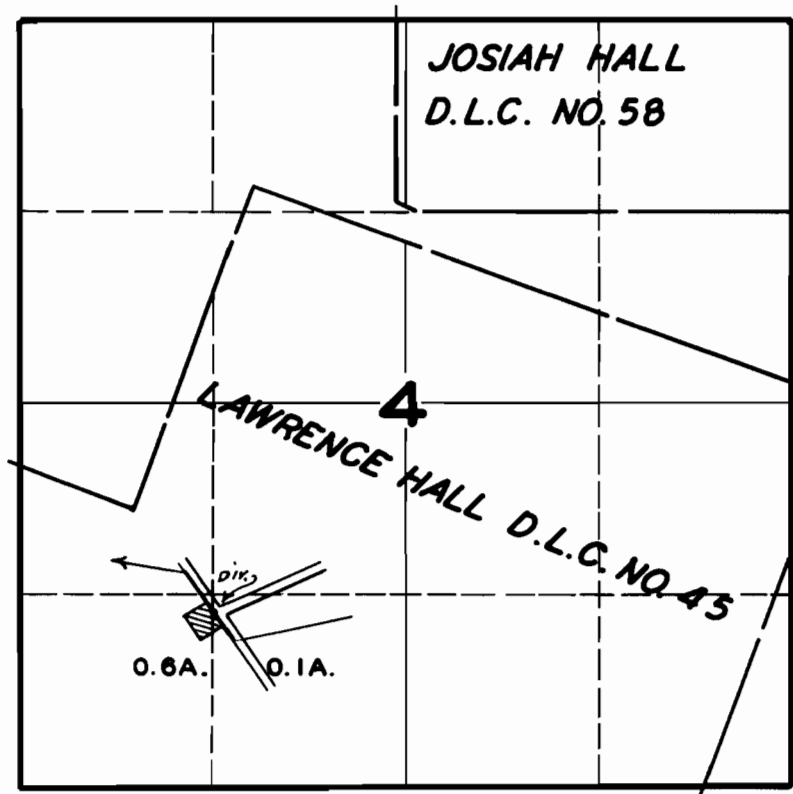

FINAL PROOF SURVEY

UNDER

Application No. 20529... Permit No. 16029...

IN NAME OF

MURRELL R. BENNETT

Surveyed MAY 5 1948, by JAS. E. BUNNELL