


T.12S.R.6W.W.M.

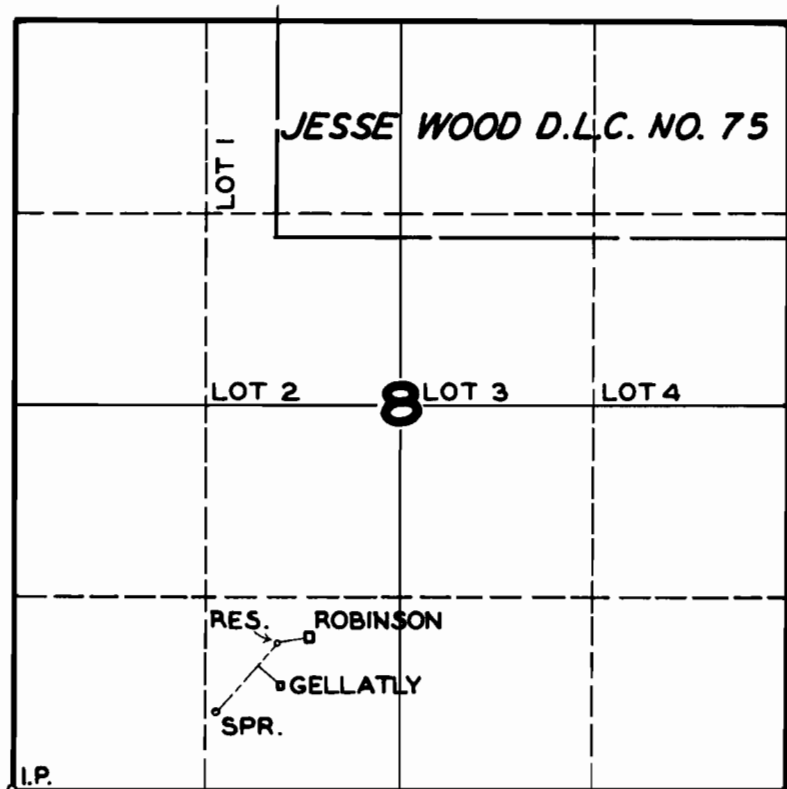

FINAL PROOF SURVEY
UNDER

Application No. **20535** Permit No. **16034**
IN NAME OF

WARD & MAMIE GELLATLY & JOHN L. ROBINSON

Surveyed **JULY 1** 1948, by **JAS. E. BUNNELL**