


**T.9S.R.1E.W.M.**

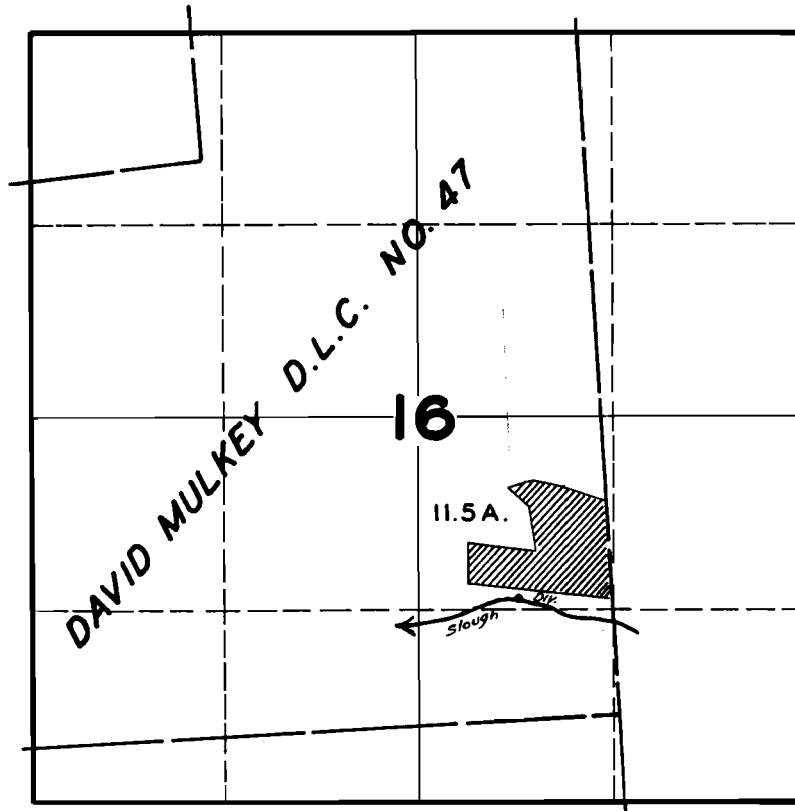

**FINAL PROOF SURVEY  
UNDER**

**Application No. 20539 Permit No. 16037**

**IN NAME OF  
R.L. MC CALL**

**Surveyed JUN. 24 1947, by JAS. E. BUNNELL**