


**T.5S.R.1W.W.M.**

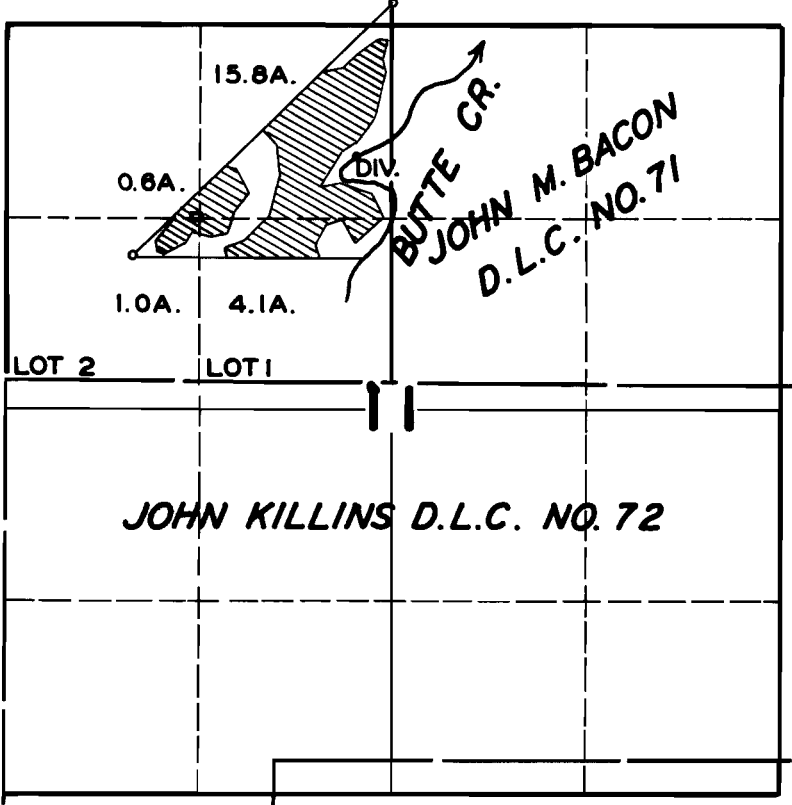

**FINAL PROOF SURVEY**

UNDER

Application No. **20579**... Permit No. **16081**.....

IN NAME OF

**C. D. OVERTON**

Surveyed **AUG. 24** 1948, by **JAS. E. BUNNELL**