


T.6S.R.1W.W.M.

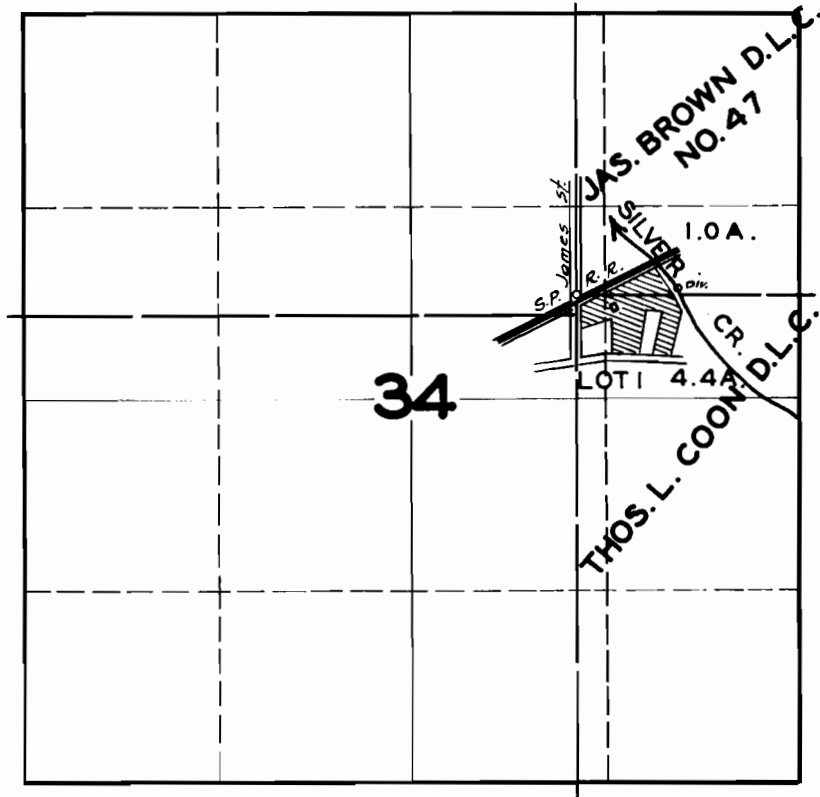

FINAL PROOF SURVEY UNDER

Application No. 20585 Permit No. 16086

IN NAME OF

HARRY C. & EDNA E. WALKER

Surveyed AUG. 4, 1947, by JAS. E. BUNNELL