


T.10S.R.6E.W.M.

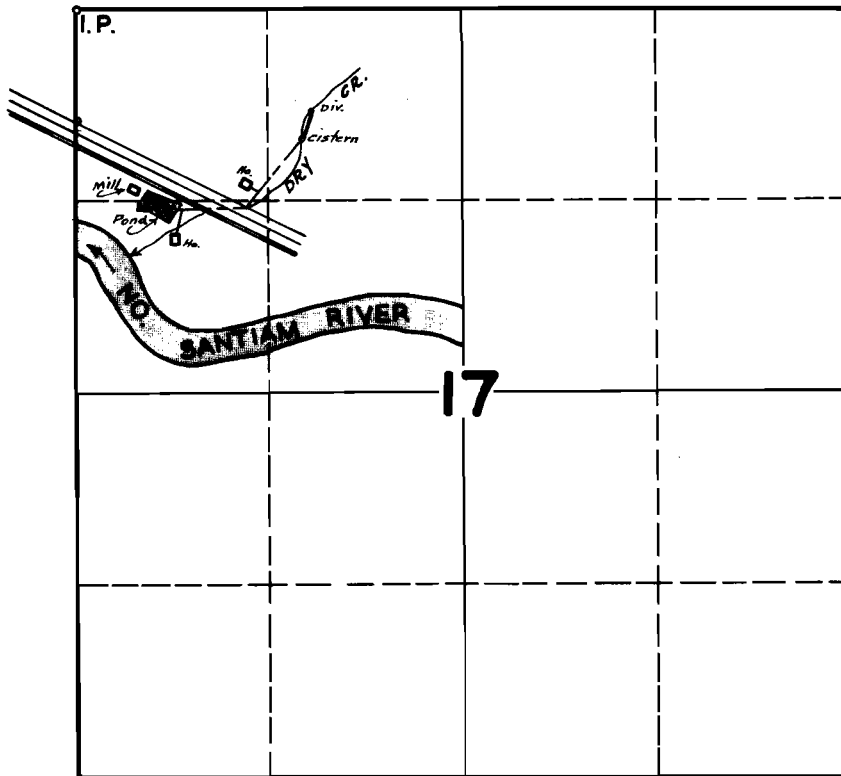

FINAL PROOF SURVEY
UNDER

Application No. 20594 Permit No. 16120

IN NAME OF

FORD HARVEY

Surveyed MAY 23, 1947, by JAS. E. BUNNELL