


**T.14S.R.1W.W.M.**

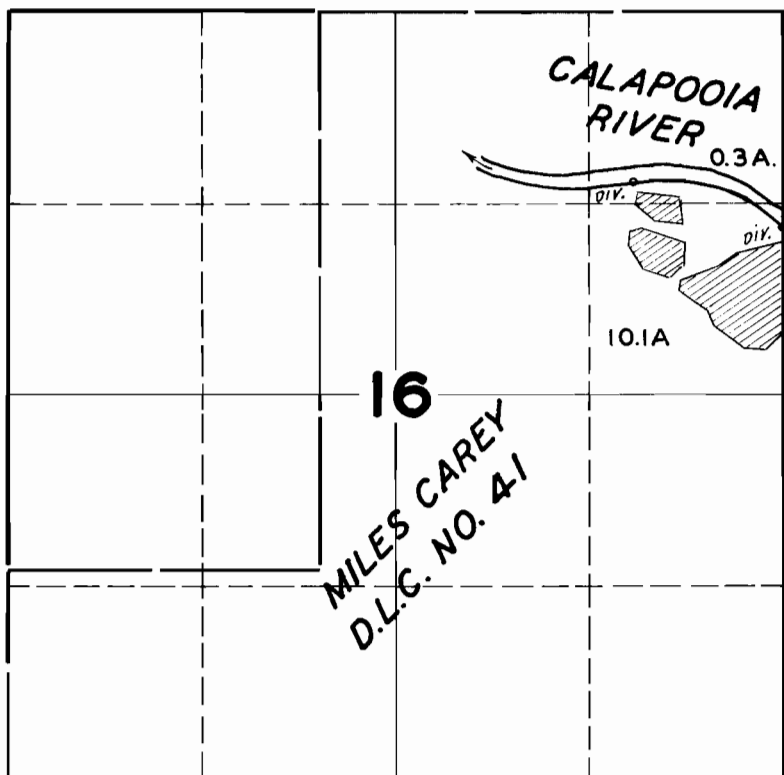

**FINAL PROOF SURVEY**

UNDER

Application No. **20626** Permit No. **16133**

IN NAME OF

**FRANK MERRITT & CLARA MERRITT**

Surveyed **MAR. 28 1949**, by **JAS. E. BUNNELL**