


**T.6N.R.35E.W.M.**

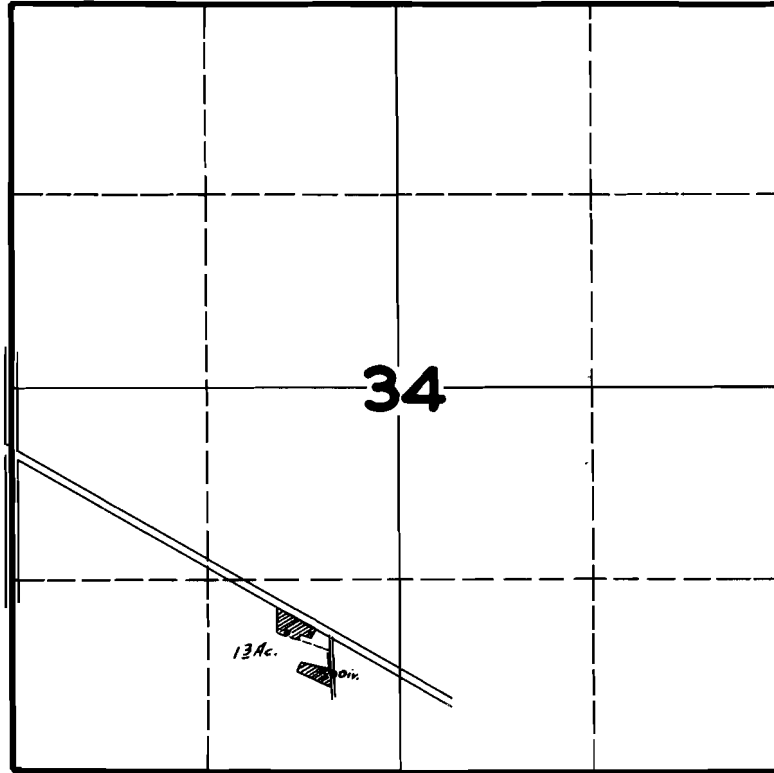

**FINAL PROOF SURVEY**

**UNDER**

**Application No. 20635 Permit No. 16140**

**IN NAME OF**

**UMATILLA COUNTY COURT**

**Surveyed APR. 19, 1946, by JAS. E. BUNNELL**