


T.14S.R.1W.W.M.

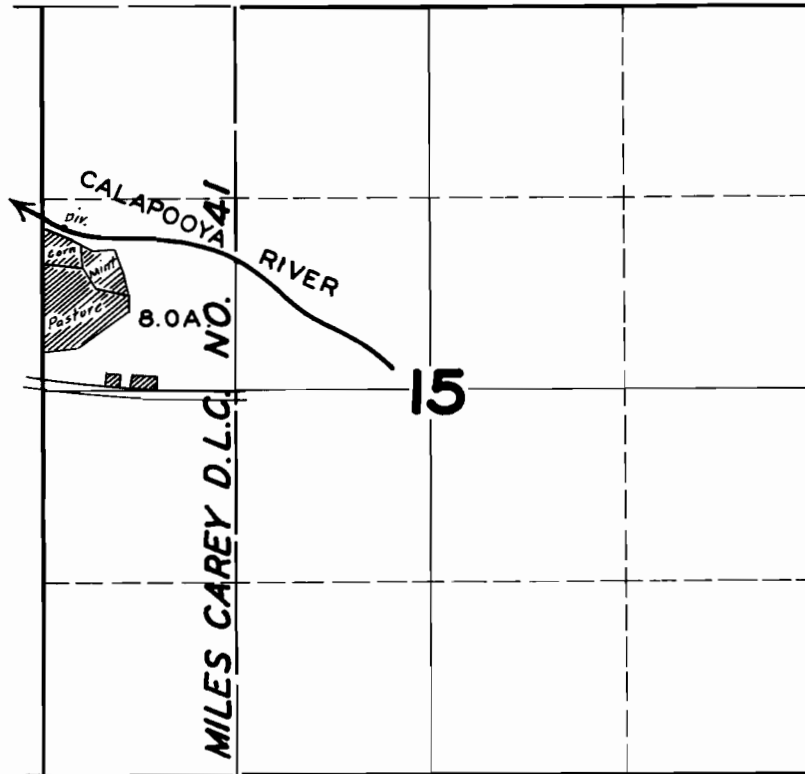

FINAL PROOF SURVEY UNDER

Application No. 20640 Permit No. 16145

IN NAME OF

FLOYD RAPP & LLOYD RAPP

Surveyed AUG. 27 1947, by JAS. E. BUNNELL