


# T.18S.R.10W.W.M.

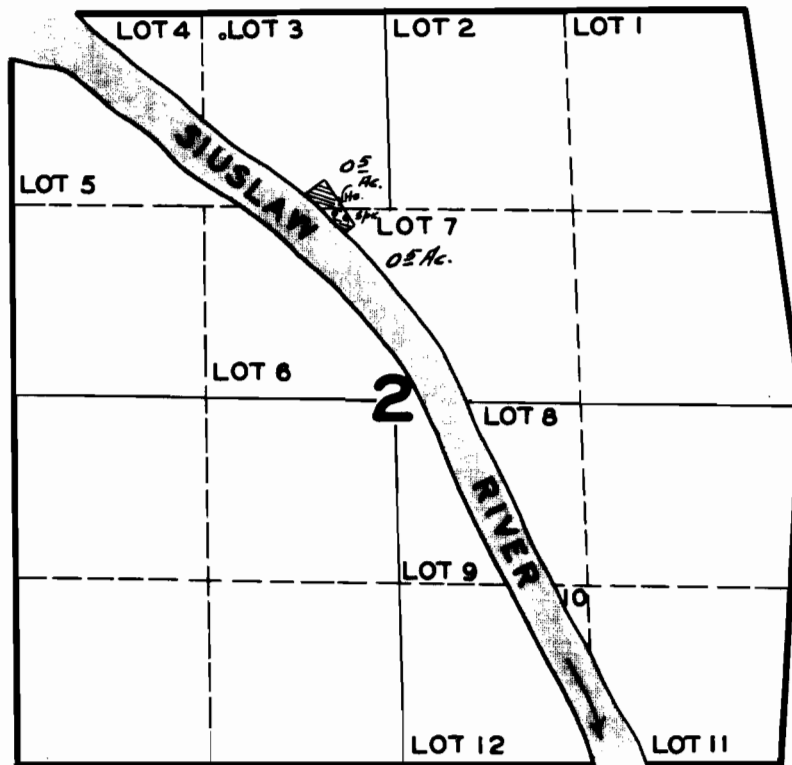

## FINAL PROOF SURVEY UNDER

Application No. 20647 Permit No. 16151

IN NAME OF

MYRON B. EATON

Surveyed AUG. 12 1947, by JAS. E. BUNNELL