


T. IN. R. 2 W. W. M.

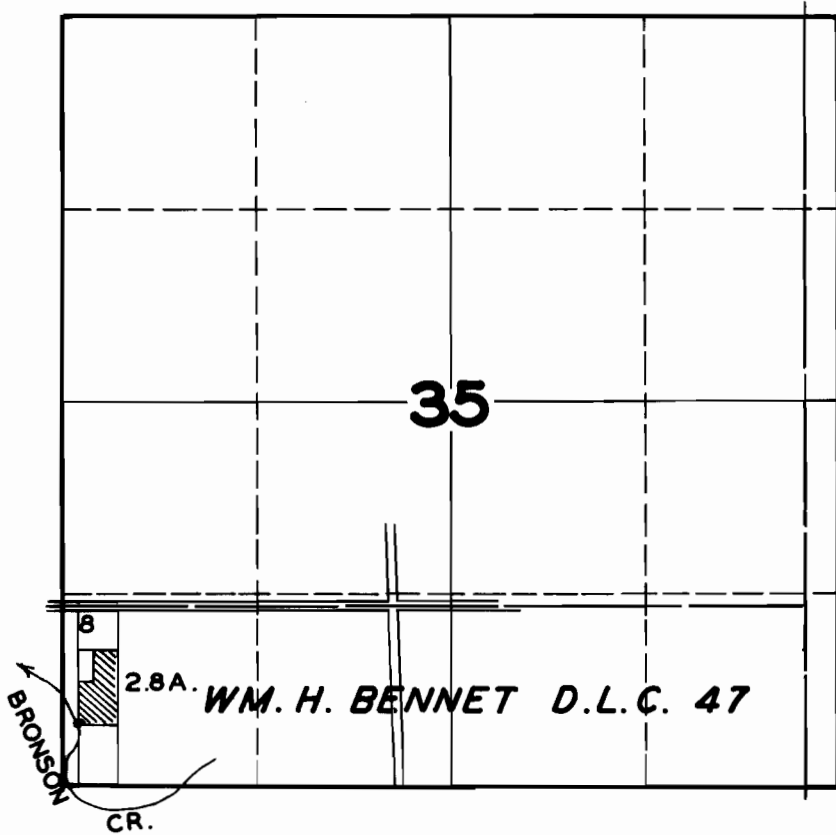

FINAL PROOF SURVEY

UNDER

Application No. **20665** ... Permit No. **16166**

IN NAME OF

ERWIN SPRINGER

Surveyed **JUL. 31** ... 1947, by **JAS. E. BUNNELL**

App No 24303

Per. No. 19058