


T. 20S. R. 12W. W.M.

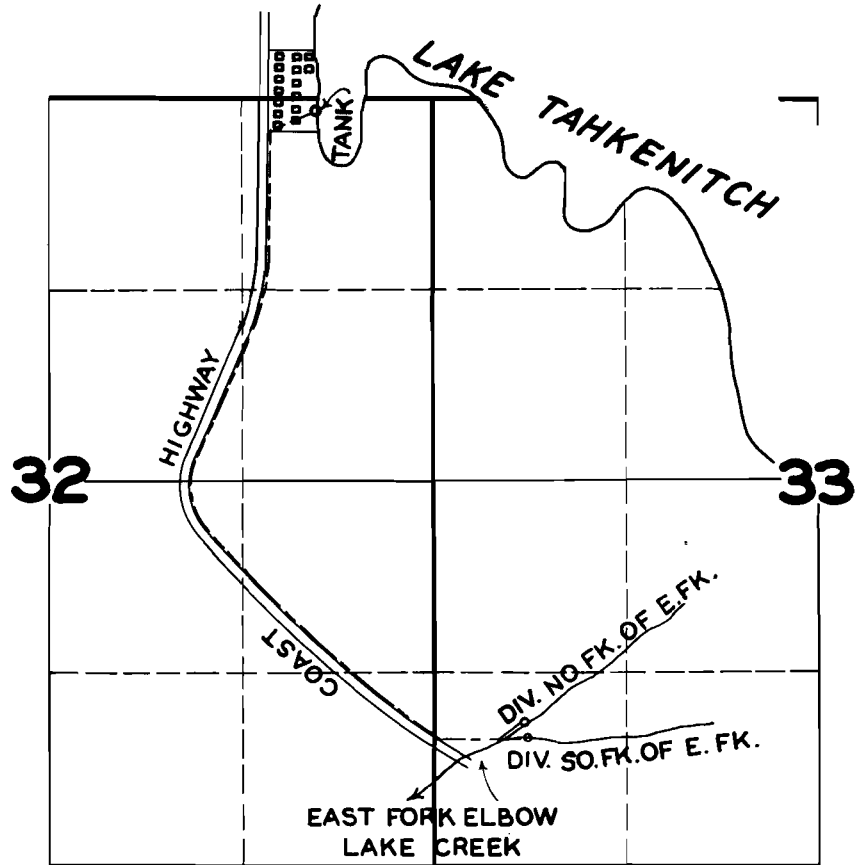

FINAL PROOF SURVEY
UNDER

Application No. 20695 Permit No. 16188
IN NAME OF

CROWN ZELLERBACH CORPORATION

Surveyed JULY 12, 1948, by JAS. E. BUNNELL