


T. 20S. R. 3W. W.M.

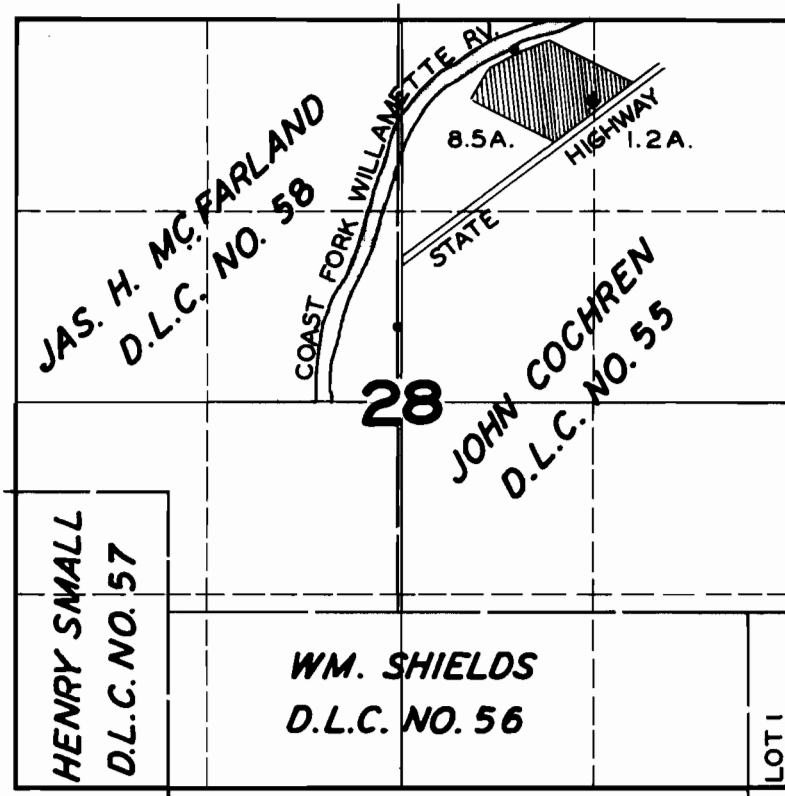

FINAL PROOF SURVEY
UNDER

Application No. **20713**..... Permit No. **16195**.....
IN NAME OF

MARGARET HECK

Surveyed **JULY 20 1948**, by **JAS. E. BUNNELL**