


T.8S.R.10W.W.M.

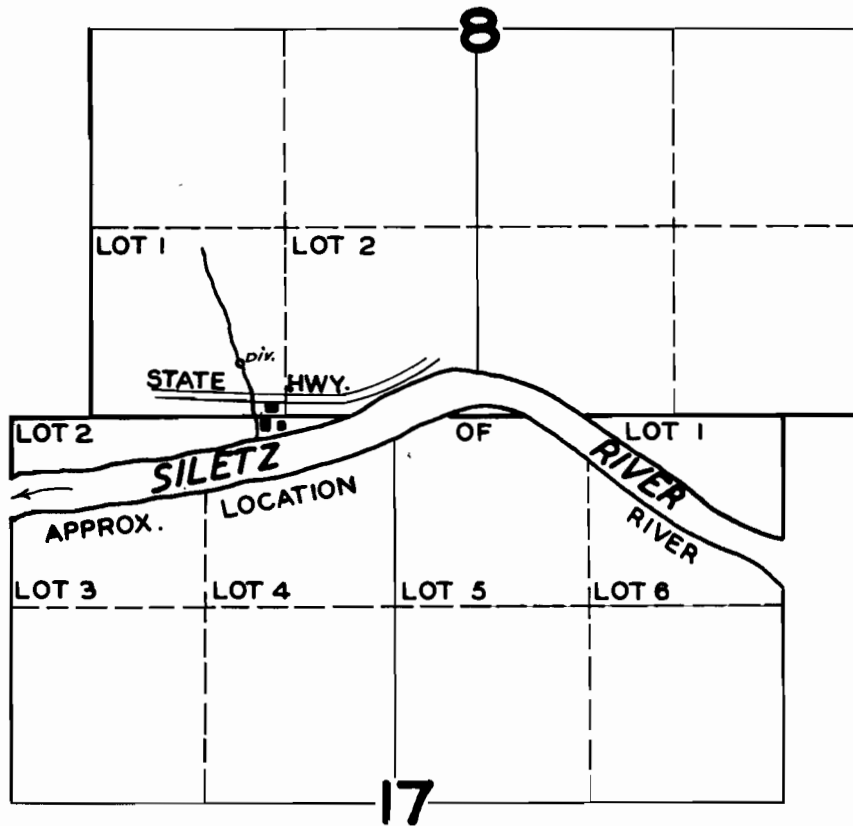

**FINAL PROOF SURVEY**  
UNDER

Application No. **20723** Permit No. **16201**  
IN NAME OF

**D. G. & ELLEN GLENN**

Surveyed **AUG. 9** 1948, by **JAS. E. BUNNELL**