


T.12S.R.6W.W.M.

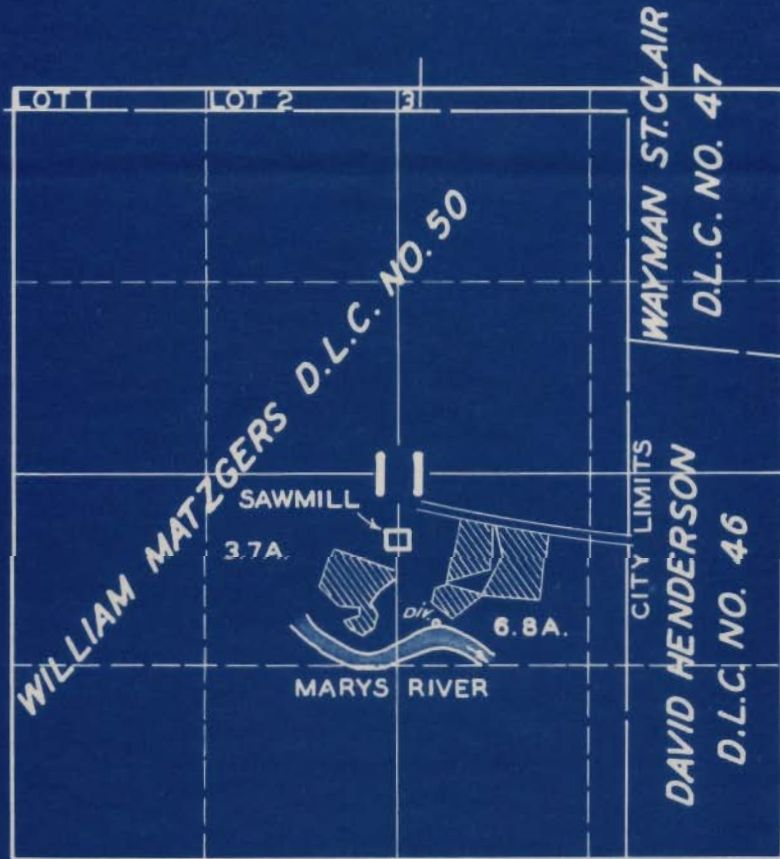

FINAL PROOF SURVEY
UNDER

Application No. **20699** Permit No. **16222**
IN NAME OF

R. E. SCOTT

Surveyed **JUNE 30 1948**, by **JAS. E. BUNNELL**