


T.3S.R.1E.W.M.

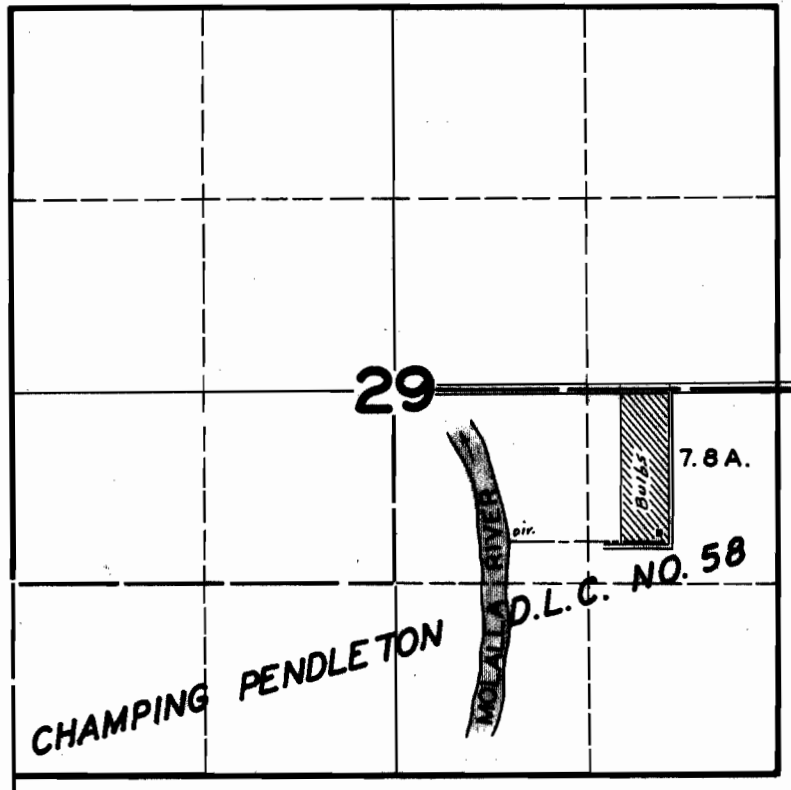

FINAL PROOF SURVEY UNDER

Application No. 20761 Permit No. 16246

IN NAME OF

R.C. START-OPERATOR-MYRTLE E. FREY-OWNER

Surveyed JUN. 10. 1947, by JAS. E. BUNNELL